

TATE
C 112
7-10-72

MISSISSIPPI
BOARD OF WATER COMMISSIONERS
416 North State Street
Jackson, Mississippi 39201

CODED

WATER WELL DRILLERS LOG

7-10 1972 Harris Bros. Tate
date well completed firm name county well located

LANDOWNER Johnny Haygen
Pt 1

description of formations encountered

Senatobia
(mailing address)

| description of formations encountered | from | to |
|---------------------------------------|------|-----|
| top soil | 0 | 15 |
| fine sand | 15 | 85 |
| Coarse sand | 85 | 100 |

WELL LOCATION:
sec. 23 T 5 N R 7 E
3 miles N of New Town
(distance) (direction) (nearest town)

WELL PURPOSE: home
(home, irrigation, municipal, industrial)

WELL COMPLETION DATA:

- (1) diameter (inches) 4
- (2) total depth (feet) 100
- (3) static water level (feet) 80 below above top of ground.
- (4) casing Plastic, 93
(material) (depth)
4 (size) If telescope see back.
- (5) screen 7, 93
(length) (depth to top)
008, Plastic
(size) (material)
- (6) pump 3/4, 10
(HP) (yield gpm)
elec.
(type power)
- (7) electric log no
(yes or no)
- (organization running log)
- (8) how well bottom plugged solid

CODED


OCT 18 1972

DRILLERS REMARKS:

MISS. BD. OF
WATER COMM.

If well telescopes please sketch and show depths.

GROUND LEVEL

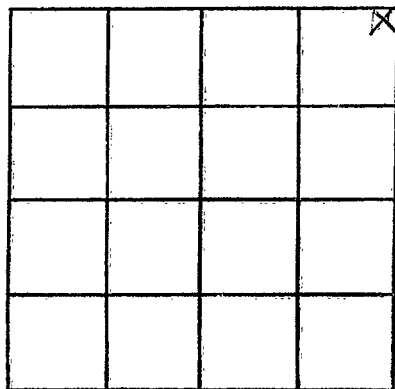

SECTION 23

Please indicate well location X.

ADDITIONAL INFORMATION

If more than one screen,
show locations of each on sketch.