

TATE
C 113
6-25-72

MISSISSIPPI
BOARD OF WATER COMMISSIONERS
416 North State Street
Jackson, Mississippi 39201

CODED

WATER WELL DRILLERS LOG

6-25 1972 Harris Bros. Tate
date well completed firm name county well located

LANDOWNER: Frank Hill
Rt. 3
Coldwater
(mailing address)

description of formations encountered	from	to
top soil	0	20
fine sand	20	80
Coarse sand	80	100

WELL LOCATION:
sec. 17 T 4 N R 6 E
3 miles NW of Androsburg
(distance) (direction) (nearest town)

WELL PURPOSE: home
(home, irrigation, municipal, industrial)

WELL COMPLETION DATA:

(1) diameter (inches) 4

(2) total depth (feet) 100

(3) static water level (feet) 20 ^{below}/_{above} top of ground.

(4) casing Plastic, 43
(material) (depth)
4 If telescope see back.
(size)

(5) screen 7, 93
(length) (depth to top)
008, Plastic
(size) (material)

(6) pump 3/4, 7
(HP) (yield gpm)
elec.
(type power)

(7) electric log no
(yes or no)

(organization running log)

(8) how well bottom plugged solid

CODED


UGI 18 1972

DRILLERS REMARKS:

FORM NO. 65
MAY 1968
MISSISSIPPI BOARD OF WATER COMMISSIONERS

If well telescopes please sketch and show depths.

GROUND LEVEL

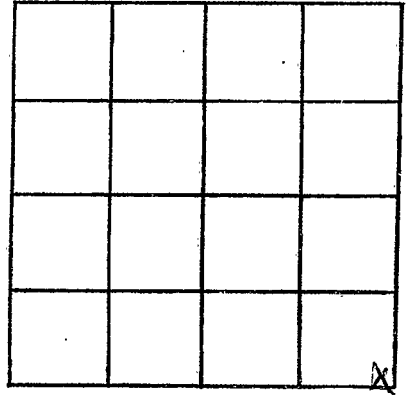

SECTION 17

Please indicate well location X.

ADDITIONAL INFORMATION

If more than one screen, show locations of each on sketch.