

MISSISSIPPI
 BOARD OF WATER COMMISSIONERS
 416 North State Street
 Jackson, Mississippi 39201

CODING

WATER WELL DRILLERS LOG

TATE
 C114
 5-1-72

5-1 1972
 date well completed

Harris Bros.
 firm name

Tate
 county well located

LANDOWNER: Roy Carter
 Rt-3
 Coldwater
 (mailing address)

description of formations encountered	from	to
top soil	0	20
white clay	20	65
clay + sand	65	125
Coarse sand	125	140

WELL LOCATION:

sec. 12 T 4 N R 6 E
 S W
 1 1/2 miles NW of New Horden
 (distance) (direction) (nearest town)

WELL PURPOSE: home
 (home, irrigation, municipal, industrial)

WELL COMPLETION DATA:

- (1) diameter (inches) 4
- (2) total depth (feet) 140
- (3) static water level (feet) 80 ^{below} _{above} top of ground.
- (4) casing Plastic, 133 (material) (depth)
 4 (size) If telescope see back.
- (5) screen 7, 133 (length) (depth to top)
 008 Plastic (size) (material)
- (6) pump 3/4, 7 (HP) (yield gpm)
 elec. (type power)
- (7) electric log No (yes or no)
 (organization running log)
- (8) how well bottom plugged solid

CODING


OCT 18 1972

DRILLERS REMARKS:

MISS. BD. OF
 WATER COMMISSIONERS

If well telescopes please sketch and show depths.

GROUND LEVEL

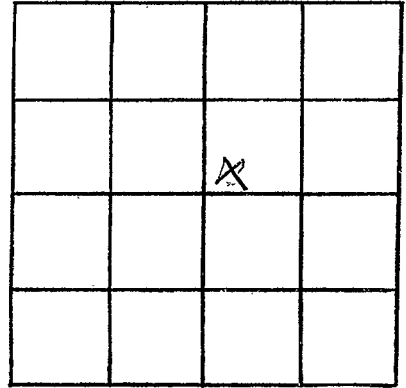

SECTION 12

Please indicate well location X.

ADDITIONAL INFORMATION

If more than one screen, show locations of each on sketch.