

MISSISSIPPI  
 BOARD OF WATER COMMISSIONERS  
 416 North State Street  
 Jackson, Mississippi 39201

WATER WELL DRILLERS LOG

TATE  
 C 115  
 6-6-72

6-6 1972 date well completed  
 Harris Bros. Zate firm name  
 county well located

LANDOWNER: L. C. Graham  
pt. 3  
Coldwater  
 (mailing address)

description of formations encountered	from	to
	top soil	0
fine sand	15	85
coarse sand	85	100

WELL LOCATION:  
 sec. 11 T. 4 N. R. 6 E.  
3 1/2 miles N of Independence  
 (distance) (direction) (nearest town)

WELL PURPOSE: home  
 (home, irrigation, municipal, industrial)

- WELL COMPLETION DATA:
- (1) diameter (inches) 4
  - (2) total depth (feet) 100
  - (3) static water level (feet) 60 below above top of ground.
  - (4) casing plastic, 93  
 (material) (depth)  
4 if telescope see back.  
 (size)
  - (5) screen 7, 93  
 (length) (depth to top)  
008, plastic  
 (size) (material)
  - (6) pump 3/4, 10  
 (HP) (yield gpm)  
elec  
 (type power)
  - (7) electric log no  
 (yes or no)  
 (organization running log)
  - (8) how well bottom plugged solid


CODER

DRILLERS REMARKS:

OCT 18 1972

If well telescopes please sketch and show depths.

GROUND LEVEL

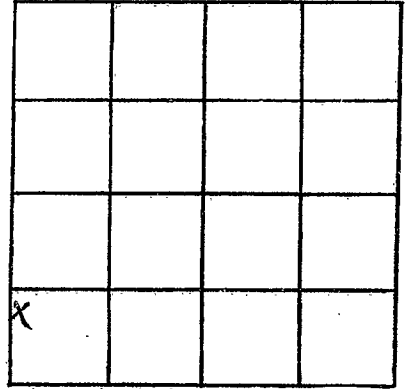

SECTION 11

Please indicate well location X.

ADDITIONAL INFORMATION

If more than one screen,  
show locations of each on sketch.