

MISSISSIPPI  
BOARD OF WATER COMMISSIONERS  
416 North State Street  
Jackson, Mississippi 39201

**CODED**

WATER WELL DRILLERS LOG

TATE  
C 116  
7-29-72

7-29  
date well completed

1972 Harris Bros.  
firm name

Tate  
county well located

LANDOWNER: Raye Anglin

Rt. 3

Coldwater

(mailing address)

WELL LOCATION:

sec. 18 T 4 N R 6 E  
1 1/2 miles W of Surline  
(distance) (direction) (nearest town)

WELL PURPOSE: home  
(home, irrigation, municipal, industrial)

WELL COMPLETION DATA:

- (1) diameter (inches) 4"
- (2) total depth (feet) 130'
- (3) static water level (feet) 90  below  above top of ground.
- (4) casing Plastic, 123  
(material) (depth)
- 4  
(size) if telescope see back.
- (5) screen 7, 123  
(length) (depth to top)
- 008, Plastic  
(size) (material)
- (6) pump 3/4, 7  
(HP) (yield gpm)
- elec.  
(type power)
- (7) electric log no  
(yes or no)
- (organization running log)
- (8) how well bottom plugged solid

description of formations encountered

from

to

top soil

0 15

red sand + pea gravel

15 45

fine sand + clay

45 115

coarse sand

115 130

**CODED**


DRILLERS REMARKS:

NOV - 1 1972

MISS. Bd. Of  
WATER COMMISSIONERS

If well telescopes please sketch and show depths.

GROUND LEVEL

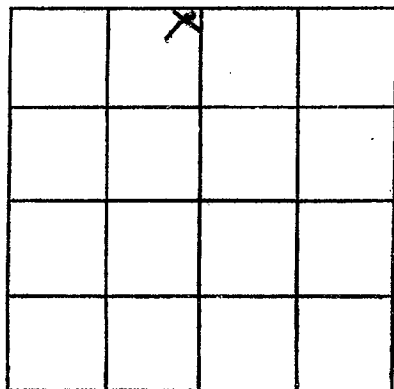

SECTION 18

Please indicate well location X.

ADDITIONAL INFORMATION

If more than one screen,  
show locations of each on sketch.