

MISSISSIPPI  
BOARD OF WATER COMMISSIONERS  
416 North State Street  
Jackson, Mississippi 39201

**CODED**

WATER WELL DRILLERS LOG

TATE  
C 117  
10-17-72

10-17-72 date well completed      22 JAMES R. Lipe firm name      Tate county well located

LANDOWNER: Melvin Atkins  
Independence  
Miss.  
(mailing address)

description of formations encountered	from	to
clay	0	30
clay and sand	30	40
clay	40	60
sand	60	120

WELL LOCATION:  
sec. 34 T 4 N R 6 E  
3 miles East of Independence  
(distance) (direction) (nearest town)

WELL PURPOSE: HOME  
(home, irrigation, municipal, industrial)

WELL COMPLETION DATA:

- (1) diameter (inches) 4
- (2) total depth (feet) 120
- (3) static water level (feet) 15 below above top of ground.
- (4) casing PVC, 110,  
(material) (depth)  
4 if telescope see back.  
(size)
- (5) screen 10, 110  
(length) (depth to top)  
4, PVC  
(size) (material)
- (6) pump 3/4, 15  
(HP) (yield gpm)  
Elec.  
(type power)
- (7) electric log no  
(yes or no)  
no  
(organization running log)
- (8) how well bottom plugged PVC  
plug


**CODED**

NOV - 1 1972

DRILLERS REMARKS:

If well telescopes please sketch and show depths.

GROUND LEVEL

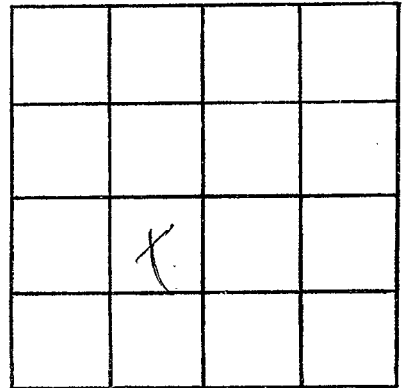

SECTION 34

Please indicate well location X.

ADDITIONAL INFORMATION

If more than one screen,  
show locations of each on sketch.