

TATE
C118
1-25-73

MISSISSIPPI
 BOARD OF WATER COMMISSIONERS
 416 North State Street
 Jackson, Mississippi 39201

CODED


WATER WELL DRILLERS LOG

1-25 1973 HICKS Bros. Well Co. TATE
 date well completed firm name county well located

LANDOWNER: <u>Charles Odum</u>	description of formations encountered	from	to
<u>RT. 2 Coldwater Miss</u>	<u>Red clay</u>	<u>0</u>	<u>15</u>
(mailing address)	<u>SAND</u>	<u>15</u>	<u>55</u>
WELL LOCATION:	<u>Red clay</u>	<u>55</u>	<u>75</u>
sec. <u>24</u> T <u>4</u> N R <u>6</u> E	<u>White sand</u>	<u>75</u>	<u>165</u>
<u>1/4</u> miles <u>E</u> of <u>Coldwater</u>			
(distance) (direction) (nearest town)			
WELL PURPOSE: <u>HOME</u>			
(home, irrigation, municipal, industrial)			
WELL COMPLETION DATA:			
(1) diameter (inches) <u>4"</u>			
(2) total depth (feet) <u>165</u>			
(3) static water level (feet) <u>90</u> below above top of ground.			
(4) casing <u>PLASTIC</u> , <u>159</u> , (material) (depth)			
_____ if telescope see back. (size)			
(5) screen <u>6"</u> , <u>6"</u> (length) (depth to top)			
<u>40"</u> , <u>Gravel plastic</u> (size) (material)			
(6) pump <u>3/4</u> , <u>10</u> (HP) (yield gpm)			
<u>220 E10C</u> (type power)			
(7) electric log <u>NO</u> (yes or no)			
_____ (organization running log)			
(8) how well bottom plugged <u>CAP</u>			
DRILLERS REMARKS:	DATE MAY 26 1973		

If well telescopes please sketch and show depths.

GROUND LEVEL

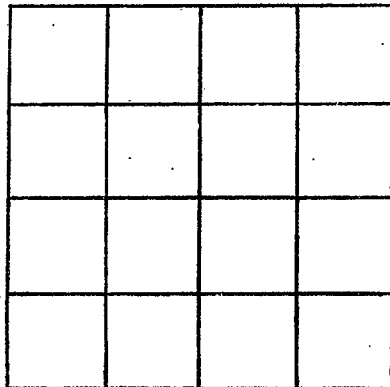

SECTION _____

Please indicate well location X.

ADDITIONAL INFORMATION

If more than one screen,
show locations of each on sketch.