

TATE
C 119
8-26-72

MISSISSIPPI
BOARD OF WATER COMMISSIONERS
416 North State Street
Jackson, Mississippi 39201

CODED

WATER WELL DRILLERS LOG

8-26-72 1972 Bob Smith Tate
date well completed firm name county well located

LANDOWNER:	description of formations encountered	from	to
<u>Sandra Menville</u>	<u>clay silt</u>		<u>8</u>
<u>Greenleaf</u> (mailing address)	<u>gravel</u>	<u>8</u>	<u>20</u>
WELL LOCATION:	<u>Red Sand</u>	<u>20</u>	<u>78</u>
sec. <u>9</u> T <u>4</u> N R <u>6</u> E <u>5 1/2</u> miles <u>West</u> of <u>Wakefield</u> (distance) (direction) (nearest town)	<u>Blue clay</u>	<u>78</u>	<u>128</u>
	<u>White sand</u>	<u>128</u>	<u>156</u>

WELL PURPOSE: Home
(home, irrigation, municipal, industrial)

- WELL COMPLETION DATA:
- (1) diameter (inches) 4
 - (2) total depth (feet) 156
 - (3) static water level (feet) 42 below above top of ground.
 - (4) casing Plastic, 15'
(material) (depth)
(size) if telescope see back.
 - (5) screen 30, 136
(length) (depth to top)
4, Plastic
(size) (material)
 - (6) pump 1/2, 10
(HP) (yield gpm)
Electric
(type power)
 - (7) electric log no
(yes or no)
- (organization running log)
- (8) how well bottom plugged plugged


CODED

FEB 09 1973

DRILLERS REMARKS:

If well telescopes please sketch and show depths.

GROUND LEVEL

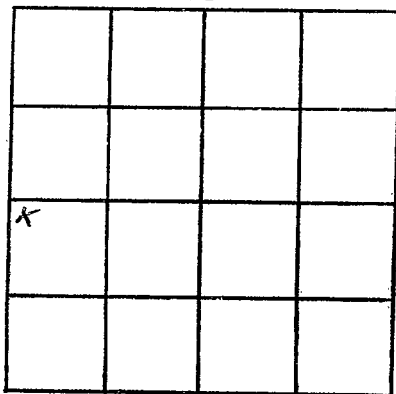

SECTION 9

Please indicate well location X.

ADDITIONAL INFORMATION

If more than one screen,
show locations of each on sketch.