

TATE
C 121
10-5-72

MISSISSIPPI
BOARD OF WATER COMMISSIONERS
416 North State Street
Jackson, Mississippi 39201

CODED

WATER WELL DRILLERS LOG

10-5-1972 Bob Smith Tate
date well completed firm name county well located

LANDOWNER:	description of formations encountered	from	to
John Hunt	clay & int		15
Sheebee (mailing address)	Red sand	15	50
	white sand	50	100

WELL LOCATION:
sec. 16 T 4 N R 6 E
5 1/2 miles West of Wakefield
(distance) (direction) (nearest town)

WELL PURPOSE: Home
(home, irrigation, municipal, industrial)

CODED


- WELL COMPLETION DATA:
- (1) diameter (inches) 4
 - (2) total depth (feet) 100
 - (3) static water level (feet) 45 below above top of ground.
 - (4) casing Plastic, 100, (material) (depth), (size) if telescope see back.
 - (5) screen 20, 80 (length) (depth to top) 4, Plastic (size) (material)
 - (6) pump 3/4 (HP) 15 (yield gpm) Electric (type power)
 - (7) electric log no (yes or no)
 - (organization running log)
 - (8) how well bottom plugged plugged

DRILLERS REMARKS:

FEB 28 1973

If well telescopes please sketch and show depths.

GROUND LEVEL

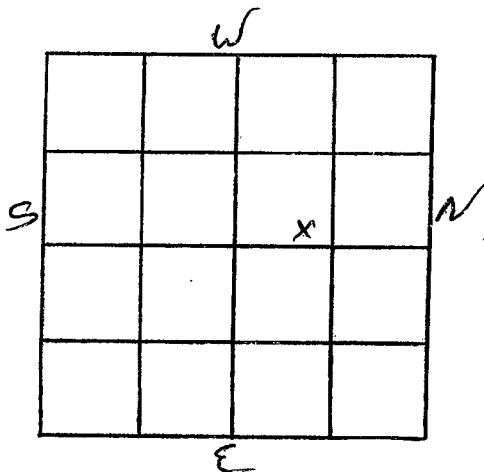

SECTION 16

Please indicate well location X.

ADDITIONAL INFORMATION

If more than one screen, show locations of each on sketch.