

TATE
C 123
8-25-72

MISSISSIPPI
BOARD OF WATER COMMISSIONERS
416 North State Street
Jackson, Mississippi 39201

CODED

WATER WELL DRILLERS LOG


8-25 1972 Bob Smith Tate
date well completed firm name county well located

LANDOWNER:	description of formations encountered	from	to
<u>Virgil Galen</u>			
<u>Greenlee</u> (mailing address)	<u>gravel</u>	<u>10</u>	<u>70</u>
WELL LOCATION: <u>SWNE</u>	<u>white clay</u>	<u>70</u>	<u>80</u>
sec. <u>5</u> T. <u>4</u> N. R. <u>6E</u> <u>(S)</u> <u>(W)</u>	<u>white sand</u>	<u>80</u>	<u>140</u>
<u>6 1/2</u> miles <u>NW</u> of <u>Wakefield</u> (distance) (direction) (nearest town)			
WELL PURPOSE: <u>None</u> (home, irrigation, municipal, industrial)			
WELL COMPLETION DATA:			
(1) diameter (inches) <u>4</u>	CODED		
(2) total depth (feet) <u>140</u>			
(3) static water level (feet) <u>100</u> below above top of ground.			
(4) casing <u>Plastic</u> , <u>140</u> (material) (depth)			
(size) if telescope see back.			
(5) screen <u>20</u> , <u>150</u> (length) (depth to top)			
<u>4</u> , <u>Plastic</u> (size) (material)			
(6) pump <u>1/2</u> , <u>10</u> (HP) (yield gpm)			
<u>Elec.</u> (type power)			
(7) electric log <u>no</u> (yes or no)			
(organization running log)			
(8) how well bottom plugged <u>plugged</u>			
DRILLERS REMARKS:			

FEB 68

If well telescopes please sketch and show depths.

GROUND LEVEL

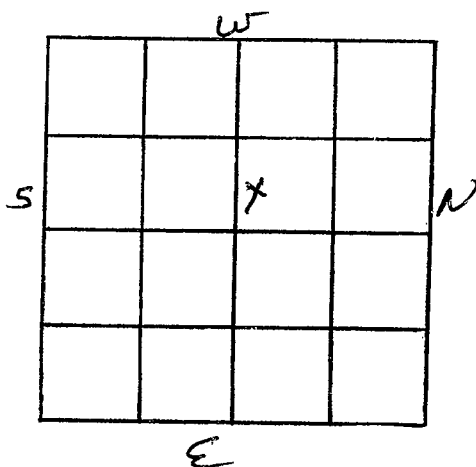

SECTION 5

Please indicate well location X.

ADDITIONAL INFORMATION

If more than one screen,
show locations of each on sketch.