

MISSISSIPPI
BOARD OF WATER COMMISSIONERS
416 North State Street
Jackson, Mississippi 39201

CODED

WATER WELL DRILLERS LOG

TATE
C 124
9-4-72

9-4
date well completed

1972 Harris Bras.
firm name

Lute
county well located

LANDOWNER: Wilbur Taylor
Rt. 2
Coldwater
(mailing address)

description of formations encountered	from	to
top soil	0	20
red sand + clay	20	65
clay + sand	65	125
Coarse white sand	125	140

WELL LOCATION:
sec 36 T 4 N R 6 E
1 1/2 miles S of Andance
(distance) (direction) (nearest town)

WELL PURPOSE:
(home, irrigation, municipal, industrial)

- WELL COMPLETION DATA:
- diameter (inches) 4
 - total depth (feet) 140
 - static water level (feet) 80 below top of ground.
 - casing Plastic, 133 (material) (depth)
4" if telescope see back. (size)
 - screen 7', 133" (length) (depth to top)
008, Plastic (size) (material)
 - pump 3/4, 7 (HP) (yield gpm)
elec. (type power)
 - electric log no (yes or no)
(organization running log)
 - how well bottom plugged shd


CODED

DRILLERS REMARKS:

ISSUED 12/19/73

If well telescopes please sketch and show depths.

GROUND LEVEL

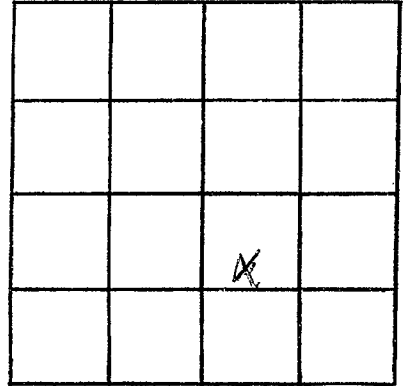

SECTION 36

Please indicate well location X.

ADDITIONAL INFORMATION

If more than one screen,
show locations of each on sketch.