

MISSISSIPPI
BOARD OF WATER COMMISSIONERS
416 North State Street
Jackson, Mississippi 39201

CODED

WATER WELL DRILLERS LOG

TATE
C125
9-15-72

9-15 date well completed 1972 Harris Bros. firm name Tate county well located

LANDOWNER: Gary Walker

Independence

(mailing address)

WELL LOCATION:

sec 26 T 4 N 6 R 6 E
1/2 miles E of Independence
(distance) (direction) (nearest town)

WELL PURPOSE: none
(home, irrigation, municipal, industrial)

WELL COMPLETION DATA:

- (1) diameter (inches) 4
- (2) total depth (feet) 120
- (3) static water level (feet) 80 below top of ground.
- (4) casing Plastic, 113 (material) (depth)
4 (size) if telescope see back.
- (5) screen 7, 113 (length) (depth to top)
008, Plastic (size) (material)
- (6) pump 3/4, 10 (HP) (yield gpm)
elec. (type power)
- (7) electric log no (yes or no)
- (organization running log)
- (8) how well bottom plugged solid

description of formations encountered

from to

<u>top soil</u>	<u>0</u>	<u>20</u>
<u>red sand</u>	<u>20</u>	<u>45</u>
<u>clay sand</u>	<u>45</u>	<u>110</u>
<u>course sand</u>	<u>110</u>	<u>120</u>

CODED


DRILLERS REMARKS:

MAP 10 1972
WATER 1 1972

MISS. ED. BY
1972

If well telescopes please sketch and show depths.

GROUND LEVEL

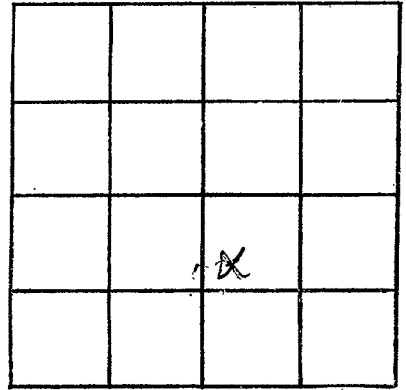

SECTION 26

Please indicate well location X.

ADDITIONAL INFORMATION

If more than one screen, show locations of each on sketch.