

MISSISSIPPI
BOARD OF WATER COMMISSIONERS
416 North State Street
Jackson, Mississippi 39201

CODED

WATER WELL DRILLERS LOG

TATE
C126
1-22-73

1-22 date well completed 1973 Harris Bros. firm name Tate county well located

LANDOWNER: J. W. Blasinger

description of formations encountered

from to

pt. 2

Coldwater

(mailing address)

top soil

0 15

white clay soil

15 105

coarse sand

105 117

WELL LOCATION:

sec. 34 T. 4 N. R. 6 E. S. 3 of Independence
1 miles (distance) S (direction) Independence (nearest town)

WELL PURPOSE: home
(home, irrigation, municipal, industrial)

WELL COMPLETION DATA:


- (1) diameter (inches) 4
- (2) total depth (feet) 117
- (3) static water level (feet) 80 below above top of ground.
- (4) casing Plastic, 110 (material) (depth)
4 (size) if telescope see back.
- (5) screen 7, 110 (length) (depth to top)
008, Plastic (size) (material)
- (6) pump 3/4, 7 (HP) (yield gpm)
elec. (type power)
- (7) electric log no (yes or no)
- (8) how well bottom plugged sealed

CODED

DRILLERS REMARKS:

If well telescopes please
sketch and show depths.

GROUND LEVEL

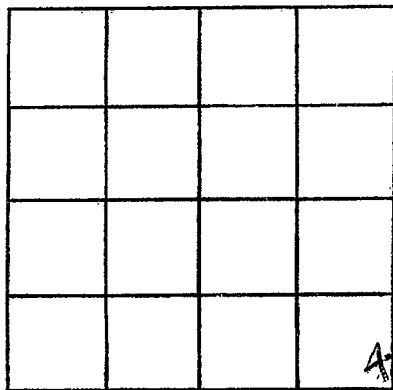

SECTION 34

Please indicate well location X.

ADDITIONAL INFORMATION

If more than one screen,
show locations of each on sketch.