

MISSISSIPPI
 BOARD OF WATER COMMISSIONERS
 416 North State Street
 Jackson, Mississippi 39201

CODED

WATER WELL DRILLERS LOG

TATE
 C127
 1-29-73

1-29 1973 Harris Bros. Tate
 date well completed firm name county well located

LANDOWNER: James R. Carson

description of formations encountered

RT-2
Coldwater
 (mailing address)

description of formations encountered	from	to
<u>top soil</u>	<u>0</u>	<u>15</u>
<u>red sand</u>	<u>15</u>	<u>50</u>

WELL LOCATION:
 sec. 36 T. 4 N. R. 6 E.
1 1/2 miles E of Independence
 (distance) (direction) (nearest town)

<u>fine sand & clay</u>	<u>50</u>	<u>115</u>
<u>coarse sand</u>	<u>115</u>	<u>130</u>

WELL PURPOSE: none
 (home, irrigation, municipal, industrial)

WELL COMPLETION DATA:

- (1) diameter (inches) 4
- (2) total depth (feet) 130
- (3) static water level (feet) 80 below above top of ground.
- (4) casing Plastic, 123
 (material) (depth)
4 If telescope see back.
 (size)
- (5) screen #7, 123
 (length) (depth to top)
nos, Plastic
 (size) (material)
- (6) pump 3/4 10
 (HP) (yield gpm)
elec.
 (type power)
- (7) electric log no
 (yes or no)
- (organization running log)
- (8) how well bottom plugged solid


CODED

DRILLERS REMARKS:

WHS 80 130

If well telescopes please sketch and show depths.

GROUND LEVEL

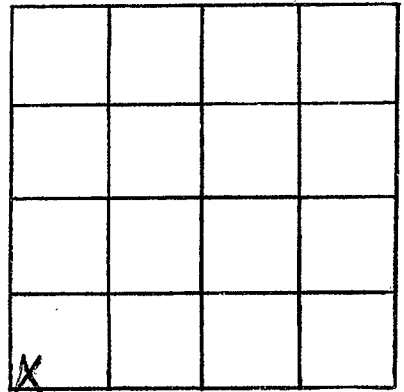

SECTION 36

Please indicate well location X.

ADDITIONAL INFORMATION

If more than one screen,
show locations of each on sketch.