

MISSISSIPPI
BOARD OF WATER COMMISSION
416 North State Street
Jackson, Mississippi 39201

CODED

WATER WELL DRILLERS LOG

TATE
C 128
11-25-72

11-25 1972 date well completed
Harris Bros. firm name
Tate county well located

LANDOWNER: Clarence Williams

description of formations encountered

from to

pt. 3

Coldwater

(mailing address)

top soil

0 15

red sand

15 35

WELL LOCATION:

sec 36 T 4 N R 6 E
1 1/2 miles W of Best
(distance) (direction) (nearest town)

white clay

35 65

sand + clay

65 95

WELL PURPOSE: home
(home, irrigation, municipal, industrial)

Coarse sand

95 110

WELL COMPLETION DATA:

- (1) diameter (inches) 4
- (2) total depth (feet) 110
- (3) static water level (feet) 80 below top of ground.
- (4) casing Plastic, 103 (material) (depth)
4 (size) if telescope see back.
- (5) screen 7, 103 (length) (depth to top)
008, Plastic (size) (material)
- (6) pump 3/4, 10 (HP) (yield gpm)
elec. (type power)
- (7) electric log no (yes or no)
- (organization running log)
- (8) how well bottom plugged solid


CODED

DRILLERS REMARKS:

MISSISSIPPI
WATER 30 1972

If well telescopes please sketch and show depths.

GROUND LEVEL

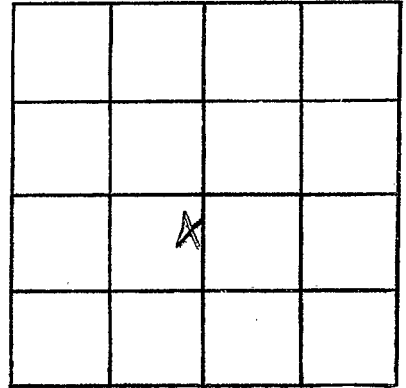

SECTION 36

Please indicate well location X.

ADDITIONAL INFORMATION

If more than one screen, show locations of each on sketch.