

MISSISSIPPI
BOARD OF WATER COMMISSIONERS
416 North State Street
Jackson, Mississippi 39201

CODED

TATE
C 129
11-10-72

WATER WELL DRILLERS LOG

11-10 1972 Harris Bros. Tate
date well completed firm name county well located

LANDOWNER: Ralph Barnell

description of formations encountered

from to

Rt. 3
Coldwater
(mailing address)

top soil	0	20
clay + sand mixed	20	125
coarse sand	125	140

WELL LOCATION:

sec. 12 T 4 N R 6 E
3/4 miles NW of New Garden
(distance) (direction) (nearest town)

WELL PURPOSE: home
(home, irrigation, municipal, industrial)

WELL COMPLETION DATA:

- (1) diameter (inches) 4
- (2) total depth (feet) 140
- (3) static water level (feet) 80 below top of ground.
- (4) casing Plastic, 133,
(material) (depth)
4 if telescope see back.
(size)
- (5) screen 7, 133
(length) (depth to top)
008, Plastic
(size) (material)
- (6) pump 3/4, 10
(HP) (yield gpm)
elec.
(type power)
- (7) electric log no
(yes or no)
- (organization running log)
- (8) how well bottom plugged solid


CODED

DRILLERS REMARKS:

NOV 20 1972
MAR 20 1972

If well telescopes please sketch and show depths.

GROUND LEVEL

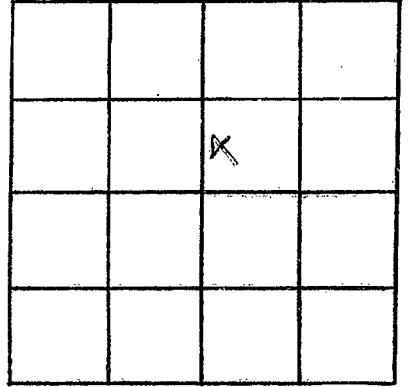

SECTION 12

Please indicate well location X.

ADDITIONAL INFORMATION

If more than one screen, show locations of each on sketch.