

MISSISSIPPI
BOARD OF WATER COMMISSIONER
416 North State Street
Jackson, Mississippi 39201

CODED

WATER WELL DRILLERS LOG

TATE
C130
11-30-72

11-30 1972 Harris Bros. Tate
date well completed firm name county well located

LANDOWNER: John Fancy
4625 Turtle Creek Circle
Memphis, Tenn.
(mailing address)

WELL LOCATION:
sec. 36 T 4 N R 6 E
1 1/2 miles W of Beaumont
(distance) (direction) (nearest town)

WELL PURPOSE: Subdivision
(home, irrigation, municipal, industrial)

- WELL COMPLETION DATA:
- diameter (inches) 4
 - total depth (feet) 160
 - static water level (feet) 80 below top of ground
 - casing Plastic, 146
(material) (depth)
4 if telescope see back.
(size)
 - screen 14, 146
(length) (depth to top)
008, Plastic
(size) (material)
 - pump 2 ~~30~~ 30
(HP) (yield gpm)
elec.
(type power)
 - electric log no
(yes or no)
(organization running log)
 - how well bottom plugged solid

description of formations encountered	from	to
top soil	0	20
white clay	20	45
clay + sand	45	90
fine sand	90	135
Coarse sand	135	160


CODED

DRILLERS REMARKS:

MARK 36 170

If well telescopes please sketch and show depths.

GROUND LEVEL

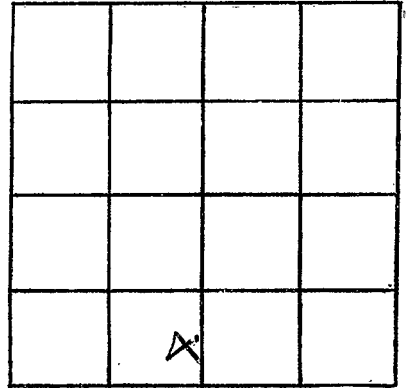

SECTION 36

Please indicate well location X.

ADDITIONAL INFORMATION

If more than one screen,
show locations of each on sketch.