

MISSISSIPPI
BOARD OF WATER COMMISSIONERS
416 North State Street
Jackson, Mississippi 39201

CODED

WATER WELL DRILLERS LOG

TATE
C131
10-25-72

10-25
date well completed

1972 Harris Bros.
firm name

Late
county well located

LANDOWNER: Bobby Brodshaw

description of formations encountered

from

to

Rt. 2

Coldwater

(mailing address)

top soil

0

20

clay + sand

20

110

coarse sand

110

130

WELL LOCATION:

sec 30 T 4 N R 6 E
1/2 miles of Bowman
(distance) (direction) (nearest town)

WELL PURPOSE: none
(home, irrigation, municipal, industrial)

WELL COMPLETION DATA:

(1) diameter (inches) 4
(2) total depth (feet) 130
(3) static water level (feet) 80 ^{below} ~~above~~ top of ground.

(4) casing Plastic, 123
(material) (depth)

4
(size) if telescope see back.

(5) screen 7, 123
(length) (depth to top)

008, Plastic
(size) (material)

(6) pump 3/4, 10
(HP) (yield gpm)

elec.
(type power)

(7) electric log no
(yes or no)

(organization running log)

(8) how well bottom plugged solid


CODED

MAR 26 1973

DRILLERS REMARKS:

If well telescopes please sketch and show depths.

GROUND LEVEL

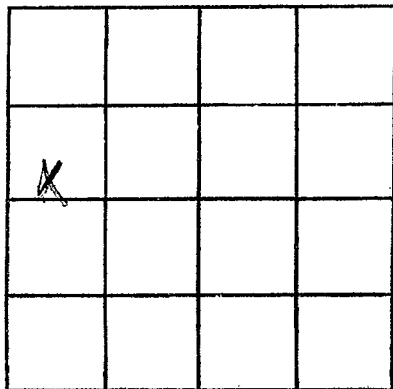

SECTION 30

Please indicate well location X.

ADDITIONAL INFORMATION

If more than one screen,
show locations of each on sketch.