

MISSISSIPPI
BOARD OF WATER COMMISSIONERS
416 North State Street
Jackson, Mississippi 39201

CODED

WATER WELL DRILLERS LOG

TATE
C132
3-14-73

3-14-1973
date well completed

Bob Smith
firm name

Jata
county well located

LANDOWNER:

Jody Mullins
Shenley - miss -
(mailing address)

description of formations encountered

from

to

clay silt		18
gravel	18	80
white clay	80	100
white sand	100	137

WELL LOCATION:

sec 5 T 4 N R 6 SE SW
7 1/2 miles NW of Wakefield
(distance) (direction) (nearest town)

WELL PURPOSE:

Home
(home, irrigation, municipal, industrial)

WELL COMPLETION DATA:

- (1) diameter (inches) 4
- (2) total depth (feet) 137
- (3) static water level (feet) 90 below top of ground.
- (4) casing Plastic, 137
(material) (depth)

_____ If telescope see back.
(size)

- (5) screen 20, 117
(length) (depth to top)

4, Plastic
(size) (material)

- (6) pump 1/2, 10
(HP) (yield gpm)

Electric
(type power)

- (7) electric log no
(yes or no)

_____ (organization running log)


- (8) how well bottom plugged Plugged

DRILLERS REMARKS:

MAR 21 1973

If well telescopes please sketch and show depths.

GROUND LEVEL

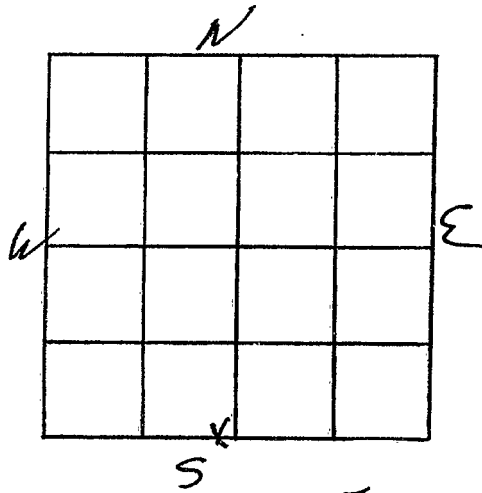

SECTION 5

Please indicate well location X.

ADDITIONAL INFORMATION

If more than one screen,
show locations of each on sketch.