

TATE
C133
4-9-73

MISSISSIPPI
BOARD OF WATER COMMISSIONERS
416 North State Street
Jackson, Mississippi 39201

CODED

WATER WELL DRILLERS LOG

4-9-1973 date well completed Bob Smith firm name Tate county well located

LANDOWNER:

Byron Harris

description of formations encountered

clay dirt

from

to

18

Coldwater - miss
(mailing address)

gravel

18 30

WELL LOCATION:

sec. 30 T 4 N R 6 E
(S) (W)
5 miles EAST of Coldwater
(distance) (direction) (nearest town)

white clay

30 90

white sand

90 128

WELL PURPOSE: drone
(home, irrigation, municipal, industrial)

WELL COMPLETION DATA:

- (1) diameter (inches) 4
- (2) total depth (feet) 128
- (3) static water level (feet) 78 below above top of ground.
- (4) casing Plastic 128
(material) (depth)
(size) if telescope see back.
- (5) screen 20 108
(length) (depth to top)
4 Plastic
(size) (material)
- (6) pump 1/3 10
(HP) (yield gpm)
Elec
(type power)
- (7) electric log no
(yes or no)

CODED

(organization running log)

(8) how well bottom plugged plugged


APR 10 1973
WTT: 2 9 1973

DRILLERS REMARKS:

MISS SD 11
1973

If well telescopes please sketch and show depths.

GROUND LEVEL

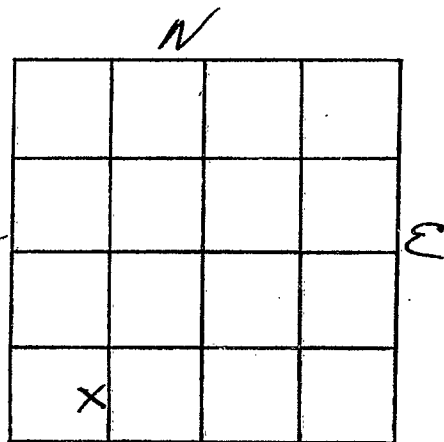

SECTION 30

Please indicate well location X.

ADDITIONAL INFORMATION

If more than one screen,
show locations of each on sketch.