

TATE
C. 134
12-72

MISSISSIPPI
BOARD OF WATER COMMISSIONERS
416 North State Street
Jackson, Mississippi 39201

CODED

WATER WELL DRILLERS LOG

Dec 1972 date well completed Leak Well Co firm name Tate Independence county well located

LANDOWNER:
JAMES Furgerson
Independence, Miss
(mailing address)

description of formations encountered	from	to
Surface Clay	1	18
Fine Sand & Clay	18	75
Clay + Coarse Sand	75	130

WELL LOCATION:
sec 35 T. 4 N R. 6 E
1/4 miles S of Independence
(distance) (direction) (nearest town)

WELL PURPOSE: Home
(home, irrigation, municipal, industrial)

WELL COMPLETION DATA:

(1) diameter (inches) 4"

(2) total depth (feet) 130

(3) static water level (feet) 52 below top of ground.

(4) casing Plastic, 130 (material), (depth)
if telescope see back.
(size)

(5) screen 12' 118 (length), (depth to top)
4 Plastic (size), (material)

(6) pump 1 1/2 40 (HP), (yield gpm)
Elec (type power)

(7) electric log (yes or no)
(organization running log)


(8) how well bottom plugged Plastic

CODED

DRILLERS REMARKS:
Well capable of producing 100 g.p.m.

If well telescopes please sketch and show depths.

GROUND LEVEL

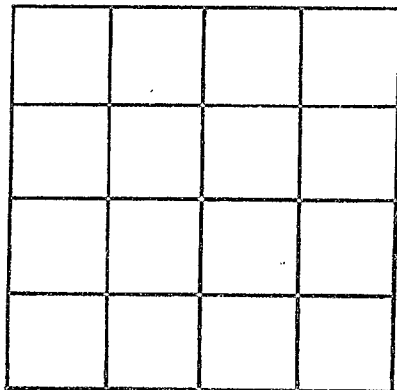

SECTION _____

Please indicate well location X.

ADDITIONAL INFORMATION

If more than one screen,
show locations of each on sketch.