

TATE
C 136
7-5-73

MISSISSIPPI
BOARD OF WATER COMMISSIONERS
416 North State Street
Jackson, Mississippi 39201

CODED

WATER WELL DRILLERS LOG

7-5-1973 date well completed Bob Smith firm name Tate county well located

LANDOWNER:
J. A. Embury
Coldwater, Miss.
(mailing address)

description of formations encountered	from	to
clay first	10	10
white clay	10	20
Red sand	20	40
gravel	40	50
white sand	50	145

WELL LOCATION:
sec. 7 T 4 N R. 6 E
7 miles NW of Water Field
(distance) (direction) (nearest town)

WELL PURPOSE: Home
(home, irrigation, municipal, industrial)

- WELL COMPLETION DATA:
- (1) diameter (inches) 4
 - (2) total depth (feet) 145
 - (3) static water level (feet) 100 below above top of ground.
 - (4) casing Plastic 145
(material) (depth)
 - if telescope see back.
(size)
 - (5) screen 20 125
(length) (depth to top)
 - 1 Plastic
(size) (material)
 - (6) pump 3/4 15
(HP) (yield gpm)
 - E lee
(type power)
 - (7) electric log no
(yes or no)
 - (organization running log)
 - (8) how well bottom plugged plugged


CODED

DRILLERS REMARKS:

SEP 27 1973

If well telescopes please sketch and show depths.

GROUND LEVEL

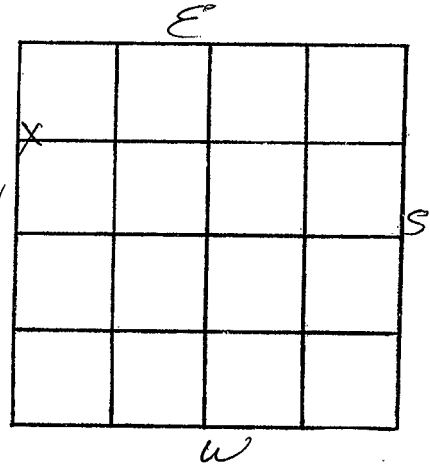

SECTION 7

Please indicate well location X.

ADDITIONAL INFORMATION

If more than one screen, show locations of each on sketch.