

TATE
 C137
 7-18-73

MISSISSIPPI
 BOARD OF WATER COMMISSIONERS
 416 North State Street
 Jackson, Mississippi 39201

CODED

WATER WELL DRILLERS LOG

7-18-1973 date well completed Bob Smith firm name Tate county well located

LANDOWNER: Hazel Louie
Independence - Miss
 (mailing address)

description of formations encountered	from	to
clay first	40	8
white clay	8	25
white sand	25	110

WELL LOCATION:
 sec. 33 T 4 N R 6 E
1 1/4 miles WEST of Independence
 (distance) (direction) (nearest town)

WELL PURPOSE: Home
 (home, irrigation, municipal, industrial)

- WELL COMPLETION DATA:
- (1) diameter (inches) 4
 - (2) total depth (feet) 110
 - (3) static water level (feet) 32 below top of ground.
 - (4) casing Plastic 110
 (material) (depth)
 (size) if telescope see back.
 - (5) screen 20 90
 (length) (depth to top)
4 Plastic
 (size) (material)
 - (6) pump 3/4 15
 (HP) (yield gpm)
Elec.
 (type power)
 - (7) electric log no
 (yes or no)
 (organization running log)
 - (8) how well bottom plugged plugged

CODED


SEP 27 1973

DRILLERS REMARKS:

MISSISSIPPI BOARD OF WATER COMMISSIONERS

If well telescopes please sketch and show depths.

GROUND LEVEL

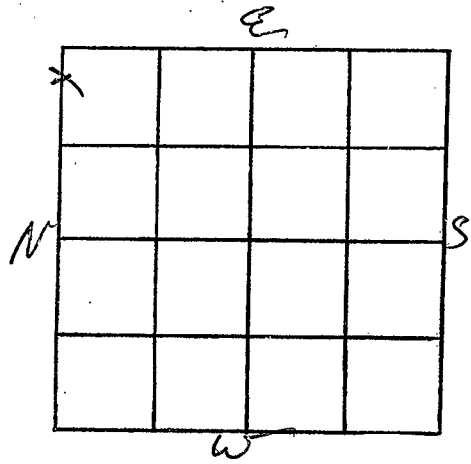

SECTION 34

Please indicate well location X.

ADDITIONAL INFORMATION

If more than one screen, show locations of each on sketch.