

TATE
 C 138
 7-13-73

MISSISSIPPI
 BOARD OF WATER COMMISSIONERS
 416 North State Street
 Jackson, Mississippi 39201

CODED

WATER WELL DRILLERS LOG

7-13-1973 date well completed Bob Smith firm name Tate county well located

LANDOWNER:	description of formations encountered	from	to
Int. man. chub	Clay dirt	40	15
Shelby - miss. (mailing address)	red sand & gravel	15	50
WELL LOCATION:	white sand	50	120
sec. <u>8</u> T. <u>4</u> N. R. <u>6</u> E. <u>6 1/4</u> miles <u>west</u> of <u>Wakarusa</u> (distance) (direction) (nearest town)	Red sand	120	130
WELL PURPOSE: <u>None</u> (home, irrigation, municipal, industrial)			
WELL COMPLETION DATA:			
(1) diameter (inches) <u>4</u>			
(2) total depth (feet) <u>130</u>			
(3) static water level (feet) <u>75</u> below above top of ground.			
(4) casing <u>Plastic</u> <u>130</u> (material) (depth) (size) if telescope see back.			
(5) screen <u>20</u> <u>110</u> (length) (depth to top) <u>4</u> <u>Plastic</u> (size) (material)			
(6) pump <u>1/2</u> <u>10</u> (HP) (yield gpm) <u>Electric</u> (type power)			
(7) electric log <u>no</u> (yes or no)			
(organization running log)			
(8) how well bottom plugged <u>plugged</u>			
DRILLERS REMARKS:			


CODED

CEP 2/1/73

MISS. Bd. of WATER COMMISSIONERS

If well telescopes please sketch and show depths.

GROUND LEVEL

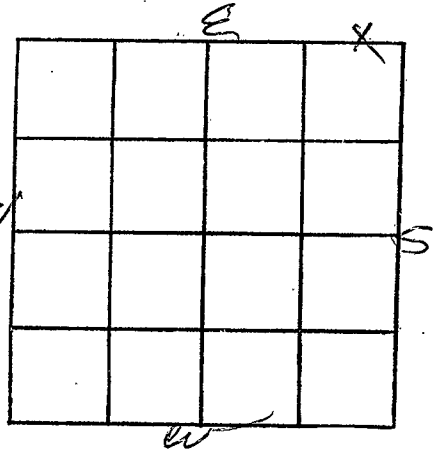

SECTION _____

Please indicate well location X.

ADDITIONAL INFORMATION

If more than one screen, show locations of each on sketch.