

TATE
C 139
5-21-73

MISSISSIPPI
BOARD OF WATER COMMISSIONERS
416 North State Street
Jackson, Mississippi 39201

WATER WELL DRILLERS LOG

5-21 1973 Harris Bros Tate
date well completed firm name county well located

LANDOWNER: Hensel Spotts
Rt. 2
Caldwater
(mailing address)

description of formations encountered	from	to
top soil	0	20
red sand	20	45
fine sand	45	80
coarse sand	80	100

WELL LOCATION:
sec. 27 T 4 N R. 6 E
1 miles W of Independence
(distance) (direction) (nearest town)

WELL PURPOSE: home
(home, irrigation, municipal, industrial)

- WELL COMPLETION DATA:
- (1) diameter (inches) 4
 - (2) total depth (feet) 100
 - (3) static water level (feet) 60 below above top of ground.
 - (4) casing Plastic, 93'
(material) (depth)
4 if telescope see back.
(size)
 - (5) screen 7, 93
(length) (depth to top)
000, Plastic
(size) (material)
 - (6) pump 3/4, 10
(HP) (yield gpm)
elec.
(type power)
 - (7) electric log NO
(yes or no)
- (organization running log)
- (8) how well bottom plugged solid


DRILLERS REMARKS:

CODED

MISS 25 1973
MISS. Bd. of
WATER COM.

If well telescopes please sketch and show depths.

GROUND LEVEL

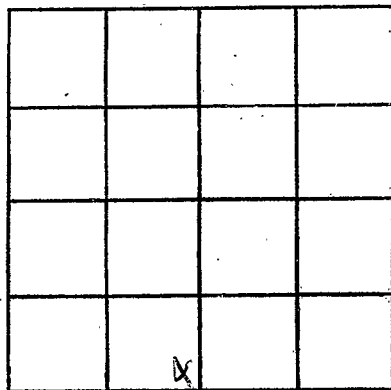

SECTION 27

Please indicate well location X.

ADDITIONAL INFORMATION

If more than one screen, show locations of each on sketch.