

LATE
C140
9-10-73

MISSISSIPPI
 BOARD OF WATER COMMISSIONERS
 416 North State Street
 Jackson, Mississippi 39201

CODED

WATER WELL DRILLERS LOG

9-10 1973 Harris Bros Late
 date well completed firm name county well located

LANDOWNER: Roy D. Wooten
Rt. 3
Coldwater
 (mailing address)

description of formations encountered	from	to
<u>top soil</u>	<u>0</u>	<u>15</u>
<u>red sand</u>	<u>15</u>	<u>40</u>
<u>clay + sand</u>	<u>40</u>	<u>90</u>
<u>Coarse sand</u>	<u>90</u>	<u>100</u>

WELL LOCATION:
 sec 26 T 4 N R 6 E
12 miles N of Clarksburg
 (distance) (direction) (nearest town)

WELL PURPOSE: home
 (home, irrigation, municipal, industrial)

- WELL COMPLETION DATA:
- (1) diameter (inches) 4
 - (2) total depth (feet) 100
 - (3) static water level (feet) 60 below above top of ground.
 - (4) casing Plastic, 93,
 (material) (depth)
4 if telescope see back.
 (size)
 - (5) screen 7, 93
 (length) (depth to top)
008 Plastic
 (size) (material)
 - (6) pump 3/4, 10
 (HP) (yield gpm)
elec
 (type power)
 - (7) electric log no
 (yes or no)
 - (organization running log)
 - (8) how well bottom plugged solid

CODED


MISS. BD. OF
 WATER COM.

DRILLERS REMARKS:

MISS. BD. OF
 WATER COM.

If well telescopes please sketch and show depths.

GROUND LEVEL

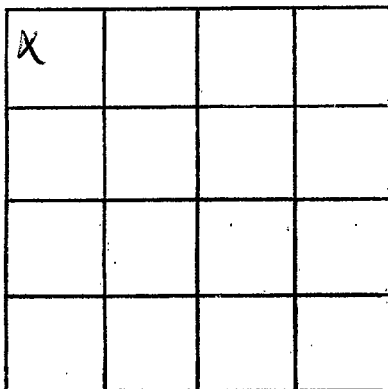

SECTION 26

Please indicate well location X.

ADDITIONAL INFORMATION

If more than one screen, show locations of each on sketch.