

LATE
 C142
 9-15-73

MISSISSIPPI
 BOARD OF WATER COMMISSIONERS
 416 North State Street
 Jackson, Mississippi 39201
CODED
 WATER WELL DRILLERS LOG


9-15 date well completed 1973 Harris Bros. firm name Tate county well located

LANDOWNER: <u>H. V. Harty, Jr.</u> <u>Rt. 4</u>	description of formations encountered	from	to
<u>Coldwater</u> (mailing address)	<u>top soil</u>	<u>0</u>	<u>20</u>
WELL LOCATION: sec <u>26</u> T <u>4</u> N R <u>6</u> E <u>1</u> miles <u>S</u> of <u>Independence</u> (distance) (direction) (nearest town)	<u>Clay + sand</u>	<u>20</u>	<u>125</u>
WELL PURPOSE: <u>Home</u> (home, irrigation, municipal, industrial)	<u>Coarse sand</u>	<u>125</u>	<u>140</u>
WELL COMPLETION DATA: (1) diameter (inches) <u>4</u> (2) total depth (feet) <u>140</u> (3) static water level (feet) <u>80</u> <u>below</u> above top of ground. (4) casing <u>Plastic</u> , <u>133</u> , (material) (depth) <u>4</u> if telescope see back. (size) (5) screen <u>7</u> , <u>133</u> (length) (depth to top) <u>008</u> , <u>Plastic</u> (size) (material) (6) pump <u>3/4</u> , <u>10</u> (HP) (yield gpm) <u>elec.</u> (type power) (7) electric log <u>no</u> (yes or no) (organization running log) (8) how well bottom plugged <u>solid</u>	<p style="text-align: center;">CODED</p>		
DRILLERS REMARKS:			

9-15-73
 MISSISSIPPI BOARD OF WATER COMMISSIONERS
 JACKSON, MISSISSIPPI

If well telescopes please sketch and show depths.

GROUND LEVEL

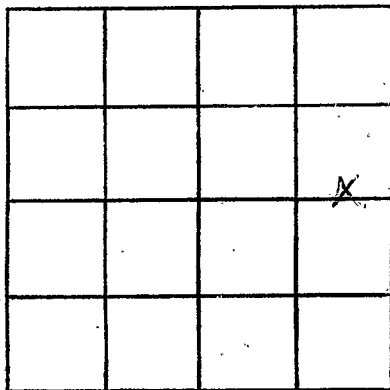

SECTION 26

Please indicate well location X.

ADDITIONAL INFORMATION

If more than one screen,
show locations of each on sketch.