

TATE  
 C 143  
 5-30-73

MISSISSIPPI  
 BOARD OF WATER COMMISSIONERS  
 416 North State Street  
 Jackson, Mississippi 39201

**CODED**

WATER WELL DRILLERS LOG


5-30 date well completed      19 73 Harris Bros. firm name      Tate county well located

LANDOWNER: Bobby Rich Pt. 3	description of formations encountered	from	to
Caldwater (mailing address)	top soil	0	15
WELL LOCATION: sec. 11 T 4 N R 6 E 1 miles W of New Hadden (distance) (direction) (nearest town)	Clay + sand	15	85
WELL PURPOSE: home (home, irrigation, municipal, industrial)	Coarse sand	85	100
WELL COMPLETION DATA: (1) diameter (inches) 4 (2) total depth (feet) 100 (3) static water level (feet) 60 below top of ground. (4) casing Plastic, 93 (material) (depth) 4 (size) if telescope see back. (5) screen 7 (length) 93 (depth to top) 100 Plastic (size) (material) (6) pump 3/4 (HP) 10 (yield gpm) elec. (type power) (7) electric log NO (yes or no) (organization running log) (8) how well bottom plugged solid	<b>CODED</b>		
DRILLERS REMARKS:			

MISS. Bd. OF  
 WATER CONTROL

If well telescopes please sketch and show depths.

GROUND LEVEL

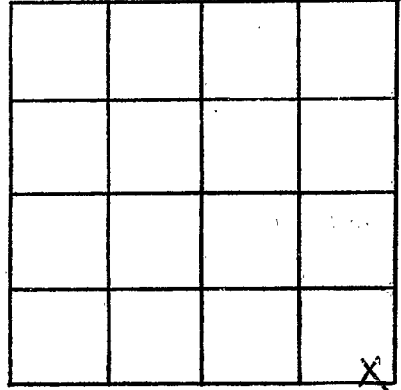

SECTION 11

Please indicate well location X.

ADDITIONAL INFORMATION

If more than one screen, show locations of each on sketch.