

TATE  
C 146  
6-8-73

MISSISSIPPI  
BOARD OF WATER COMMISSIONERS  
416 North State Street  
Jackson, Mississippi 39201

**CODED**

WATER WELL DRILLERS LOG

6-8 1973 Harris Bros. Tate  
date well completed firm name county well located

LANDOWNER:  
New Garden Baptist Church  
Rt. 3 Coldwater  
(mailing address)

description of formations encountered	from	to
top soil	0	15
fine sand + clay	15	120
coarse sand	120	130

WELL LOCATION:  
sec. 12 T. 4 N. R. 6 E.  
In New Garden  
(distance) (direction) (nearest town)

WELL PURPOSE: home  
(home, irrigation, municipal, industrial)

- WELL COMPLETION DATA:
- (1) diameter (inches) 4
  - (2) total depth (feet) 130
  - (3) static water level (feet) 60 <sup>below</sup> top of ground.
  - (4) casing P. Plastic, 123  
(material) (depth)  
4 (size) If telescope see back.
  - (5) screen 7, 123  
(length) (depth to top)  
008, P. Plastic  
(size) (material)
  - (6) pump 3/4, 7  
(HP) (yield gpm)  
elec.  
(type power)
  - (7) electric log no  
(yes or no)
  - (organization running log)
  - (8) how well bottom plugged solid

**CODED**


MISSISSIPPI STATE UNIVERSITY

DRILLERS REMARKS:

WATER WELL DRILLERS LOG

If well telescopes please sketch and show depths.

GROUND LEVEL

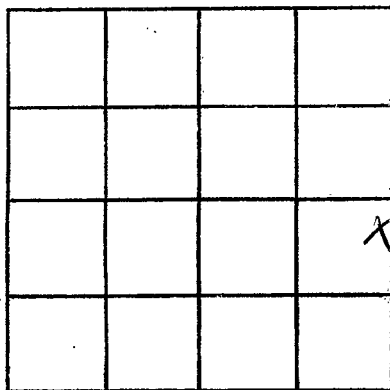

SECTION 12

Please indicate well location X.

ADDITIONAL INFORMATION

If more than one screen,  
show locations of each on sketch.