

TATE
C 147
7-6-73

MISSISSIPPI
BOARD OF WATER COMMISSIONERS
416 North State Street
Jackson, Mississippi 39201

CODED

WATER WELL DRILLERS LOG

7-6 1973 Harris Bros Tate
date well completed firm name county well located

LANDOWNER:
Zollie B. Puryear
Box 235 Coldwater
(mailing address)

description of formations encountered	from	to
top soil	0	20
sand & clay	20	130
Coarse sand	130	150

WELL LOCATION:
sec. 14 T. 4 N R. 6 E
2 miles N of Independence
(distance) (direction) (nearest town)

WELL PURPOSE: none
(home, irrigation, municipal, industrial)

- WELL COMPLETION DATA:
- (1) diameter (inches) 4
 - (2) total depth (feet) 150
 - (3) static water level (feet) 80 ^{below} _{above} top of ground.
 - (4) casing plastic, 136 (material) (depth)
4 (size) if telescope see back.
 - (5) screen 14, 136 (length) (depth to top)
108, plastic (size) (material)
 - (6) pump 3/4, 7 (HP) (yield gpm)
elec. (type power)
 - (7) electric log no (yes or no)
 - (organization running log)
 - (8) how well bottom plugged solid

CODED


DRILLERS REMARKS:

DATE 7-6-73

MISS. Bd. of WATER COM.

If well telescopes please sketch and show depths.

GROUND LEVEL

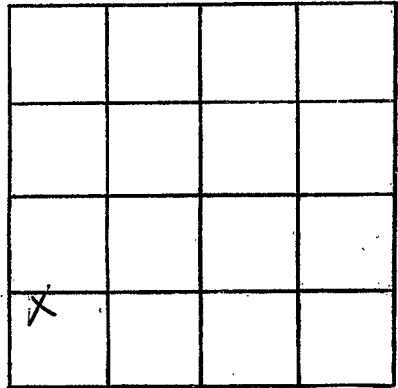

SECTION 14

Please indicate well location X.

ADDITIONAL INFORMATION

If more than one screen,
show locations of each on sketch.