

LATE
C 148
7-7-73

MISSISSIPPI
 BOARD OF WATER COMMISSIONERS
 416 North State Street
 Jackson, Mississippi 39201

CODED

WATER WELL DRILLERS LOG

7-7 1973 Harris Bros Late
 date well completed firm name county well located

LANDOWNER E. P. Mullins
Rt. 3 Box 277P
Caldwater
 (mailing address)

description of formations encountered	from	to
<u>top soil</u>	<u>0</u>	<u>20</u>
<u>sand & clay</u>	<u>20</u>	<u>130</u>
<u>Coarse sand</u>	<u>130</u>	<u>150</u>

WELL LOCATION:
 sec. 14 T 4 N R 6 E
2 miles N of Andropo
 (distance) (direction) (nearest town)

WELL PURPOSE: home
 (home, irrigation, municipal, industrial)

- WELL COMPLETION DATA:
- (1) diameter (inches) 4
 - (2) total depth (feet) 150
 - (3) static water level (feet) 80 ^{below} _{above} top of ground.
 - (4) casing plastic, 136
 (material) (depth)
4 if telescope see back.
 (size)
 - (5) screen 14, 136
 (length) (depth to top)
008, plastic
 (size) (material)
 - (6) pump 3/4, 10
 (HP) (yield gpm)
elec
 (type power)
 - (7) electric log no
 (yes or no)
 - (organization running log)
 - (8) how well bottom plugged solid


DRILLERS REMARKS:

CODED

DATE
 07 20 1973
 MISSISSIPPI
 WATER COMMISSIONERS

If well telescopes please sketch and show depths.

GROUND LEVEL

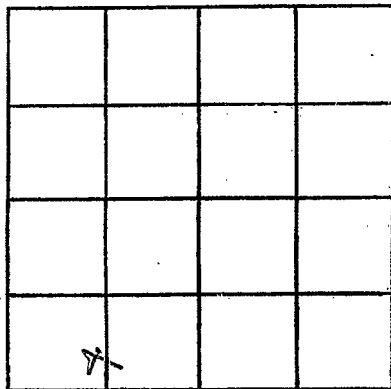

SECTION _____

Please indicate well location X.

ADDITIONAL INFORMATION

If more than one screen, show locations of each on sketch.