

TATE
C. 149
8-25-73

MISSISSIPPI
BOARD OF WATER COMMISSIONERS
416 North State Street
Jackson, Mississippi 39201

CODED

WATER WELL DRILLERS LOG

8-25 1973 Harris Bros. Tate
date well completed firm name county well located

LANDOWNER: Stanley Blair Rt. 4	description of formations encountered	from	to
Coldwater (mailing address)	top soil	0	15
	red sand	15	30
WELL LOCATION: sec. 33 T 4 N R 6 E	clay + sand	30	115
2 miles E of Bogsville (distance) (direction) (nearest town)	course sand	115	130
WELL PURPOSE: home (home, irrigation, municipal, industrial)			
WELL COMPLETION DATA:			
(1) diameter (inches) 4			
(2) total depth (feet) 130			
(3) static water level (feet) 80 ^{below} top of ground.			
(4) casing plastic, 123 (material) (depth)			
4 (size) if telescope see back.			
(5) screen 17, 123 (length) (depth to top)			
008, plastic (size) (material)			
(6) pump 3/4, 7 (HP) (yield gpm)			
elec. (type power)			
(7) electric log NO (yes or no)			
(organization running log)			
(8) how well bottom plugged solid			
DRILLERS REMARKS:			


CODED

081 23 700

MISSISSIPPI
BOARD OF WATER COMMISSIONERS

If well telescopes please sketch and show depths.

GROUND LEVEL

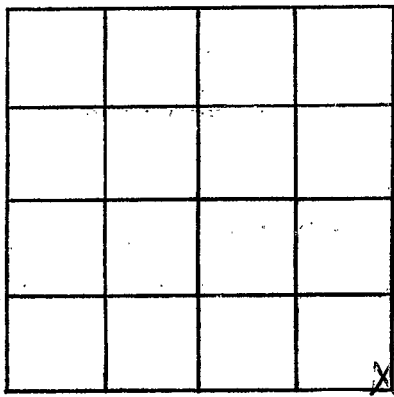

SECTION 3.3

Please indicate well location X.

ADDITIONAL INFORMATION

A series of horizontal lines for writing additional information.

If more than one screen, show locations of each on sketch.