

TATE  
 C-42150  
 10-3-73

MISSISSIPPI  
 BOARD OF WATER COMMISSIONERS  
 416 North State Street  
 Jackson, Mississippi 39201

CODED

WATER WELL DRILLERS LOG

10-3 date well completed 1973 Harris Bros. firm name Tate county well located

LANDOWNER: <u>Clark Freeman</u>	description of formations encountered	from	to
(mailing address)			
<u>pt. 3</u>	<u>top soil</u>	<u>0</u>	<u>20</u>
<u>Coldwater</u>	<u>Clay + sand</u>	<u>20</u>	<u>125</u>
<u>2 1/2 miles NW of Independence</u>	<u>Coarse sand</u>	<u>125</u>	<u>140</u>
WELL LOCATION: sec <u>27</u> T <u>4</u> N R <u>6</u> E <u>2 1/2</u> miles <u>NW</u> of <u>Independence</u> (distance) (direction) (nearest town)			
WELL PURPOSE: <u>home</u> (home, irrigation, municipal, industrial)			
WELL COMPLETION DATA: (1) diameter (inches) <u>4</u> (2) total depth (feet) <u>140</u> (3) static water level (feet) <u>80</u> <u>below</u> top of ground. (4) casing <u>Plastic</u> , <u>133</u> (material) (depth) <u>4</u> If telescope see back. (size) (5) screen <u>7</u> , <u>133</u> (length) (depth to top) <u>008</u> , <u>Plastic</u> (size) (material) (6) pump <u>3/4</u> <u>10</u> (HP) (yield gpm) <u>elec</u> (type power) (7) electric log <u>NO</u> (yes or no) (organization running log) (8) how well bottom plugged <u>solid</u>			
DRILLERS REMARKS:			


CODED

NOT 012 171

MISS. DEPT. OF REVENUE

If well telescopes please sketch and show depths.

GROUND LEVEL

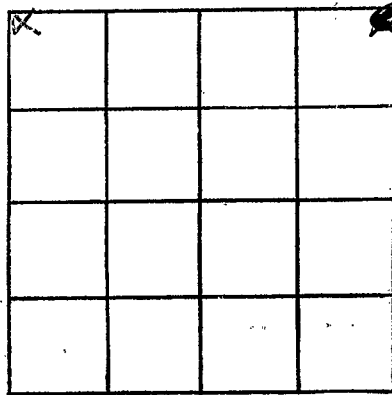

SECTION 22

Please indicate well location X.

ADDITIONAL INFORMATION

Lined area for additional information.

If more than one screen, show locations of each on sketch.