

TATE
C152
4-4-74

MISSISSIPPI
BOARD OF WATER COMMISSIONERS
416 North State Street
Jackson, Mississippi 39201

CODED

WATER WELL DRILLERS LOG

4-4-74 date well completed 74 Hicks Bros. Well Co. firm name State county well located

LANDOWNER: Senatobia
Senatobia, Miss
(mailing address)

description of formations encountered	from	to
Red Clay	0	15
White Sand	15	135

WELL LOCATION:
sec 22 T 4 N R 6 E
1/4 miles N Independence
(distance) (direction) (nearest town)

WELL PURPOSE: Municipal
(home, irrigation, municipal, industrial)

WELL COMPLETION DATA:



- (1) diameter (inches) 4 1/2
- (2) total depth (feet) 135
- (3) static water level (feet) 50 ^{below}/_{above} top of ground.
- (4) casing Plastic, 135,
(material) (depth)
if telescope see back.
(size)
- (5) screen 12 1/2, 123
(length) (depth to top)
4 1/2, Gravel
(size) (material)
- (6) pump 1 1/2
(HP) (yield gpm)
Electric
(type power)
- (7) electric log NO
(yes or no)
- (organization running log)
- (8) how well bottom plugged Cap

CODED

DRILLERS REMARKS:

If well telescopes please sketch and show depths.

GROUND LEVEL

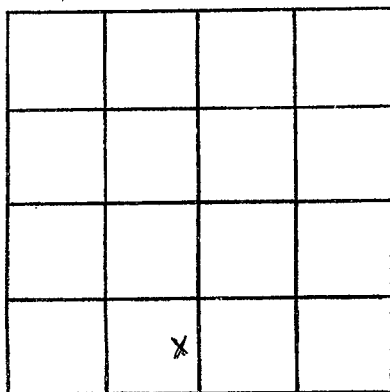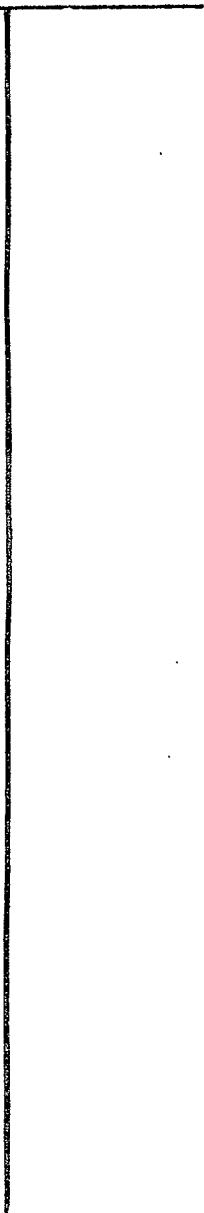

SECTION 27

Please indicate well location X.

ADDITIONAL INFORMATION

If more than one screen,
show locations of each on sketch.