

TATE  
 C161  
 6-28-74

MISSISSIPPI  
 BOARD OF WATER COMMISSIONERS  
 416 North State Street  
 Jackson, Mississippi 39201

CODED

WATER WELL DRILLERS LOG

6-28 1974 Hinds Co. W.M.C. ORT  
 date well completed firm name county well located

LANDOWNER:	description of formations encountered	from	to
John C. Wilbur - Pt 2 Colburn, Miss. (mailing address)			
WELL LOCATION:	Red clay & sand	15	30
see 35 T 4 N R 6 E 1 miles SE of Wadsworth (distance) (direction) (nearest town)	Red sand	30	45
WELL PURPOSE: <u>drainage</u> (home, irrigation, municipal, industrial)	white sand	45	90
WELL COMPLETION DATA:	white sand & clay	90	120
(1) diameter (inches) <u>4 1/2</u>	white sand	120	145
(2) total depth (feet) <u>145</u>			
(3) static water level (feet) <u>50</u> below top of ground.			
(4) casing <u>Plastic</u> <u>145</u> (material) (depth)			
(size) if telescope see back.			
(5) screen <u>4 1/2</u> <u>141</u> (length) (depth to top)			
<u>4 1/2</u> <u>brass</u> (size) (material)			
(6) pump <u>1/2</u> <u>10</u> (HP) (yield gpm)			
<u>electric</u> (type power)			
(7) electric log <u>no</u> (yes or no)			
(organization running log)			
(8) how well bottom plugged <u>cap</u>			
DRILLERS REMARKS:			

CODED


INDEXED

AUG - 2 1974

MISS. BD. OF WATER COMM

If well telescopes please sketch and show depths.

GROUND LEVEL

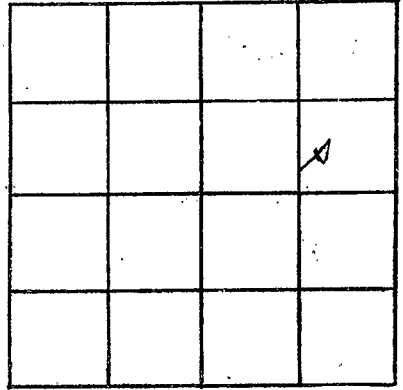

SECTION 35

Please indicate well location X.

ADDITIONAL INFORMATION

If more than one screen,  
show locations of each on sketch.