

MISSISSIPPI
 BOARD OF WATER COMMISSIONERS
 416 North State Street
 Jackson, Mississippi 39201

CODED

WATER WELL DRILLERS LOG

TATE
 C 165
 10-12-74

10/12 date well completed
 1974 JIM RENIX firm name
 TATE county well located

LANDOWNER: JOANN BOX

description of formations encountered	from	to
Shale + sand	0	90
Sand	90	107

RT 2 Box 299 Coldwater
 (mailing address) MISS

WELL LOCATION:


sec 12 T 4 N R 6 E
 (S) W
 4 miles S of Cockrum
 (distance) (direction) (nearest town)

WELL PURPOSE: Home
 (home, irrigation, municipal, industrial)

WELL COMPLETION DATA:

- (1) diameter (inches) 2 in
- (2) total depth (feet) 107
- (3) static water level (feet) 17 below top of ground. 90
- (4) casing (material) (depth) 107
 If telescope see back.
- (5) screen (length) (depth to top) 4 107
 (size) (material) gal
- (6) pump (HP) (yield gpm) 1/4 250
 (type power)
- (7) electric log (yes or no) *
- (organization running log) 25'0
- (8) how well bottom plugged 2 1/2 Bl

CODED

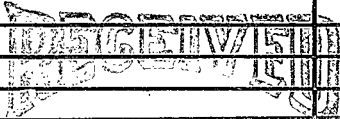

IAN 2 1975


DRILLERS REMARKS:

Jim Renix

MISS. BD. OF WATER COM

If well telescopes please sketch and show depths.

GROUND LEVEL

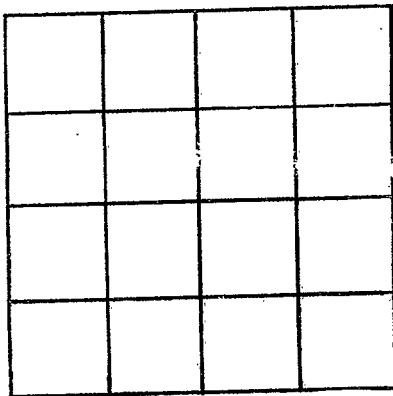

SECTION _____

Please indicate well location X.

ADDITIONAL INFORMATION

If more than one screen,
show locations of each on sketch.