

TATE
C167
10-7-74

MISSISSIPPI
BOARD OF WATER COMMISSIONERS
416 North State Street
Jackson, Mississippi 39201

CODED

WATER WELL DRILLERS LOG

10-7-74 date well completed
Harris Bros. firm name
Tate county well located

LANDOWNER: J. C. Buford
Independence

description of formations encountered	from	to
top soil	0	15
clayt sand	15	25
Coarse sand	25	100

(mailing address)
WELL LOCATION:
sec. 28 T. 4 N. R. 6 E.
1 1/4 miles W of Independence
(distance) (direction) (nearest town)

WELL PURPOSE: none
(home, irrigation, municipal, industrial)

- WELL COMPLETION DATA:
- (1) diameter (inches) 4
 - (2) total depth (feet) 100
 - (3) static water level (feet) 60 below above top of ground.
 - (4) casing plastic, 9.3 (material), (depth)
4 (size) if telescope see back.
 - (5) screen 7, 9.3 (length), (depth to top)
no. 8, plastic (size), (material)
 - (6) pump 3/4, 10 (HP), (yield gpm)
elec (type power)
 - (7) electric log no (yes or no)
 - (organization running log)
 - (8) how well bottom plugged solid


CODED

RECEIVED
MAR 1 1975

DRILLERS REMARKS:

If well telescopes please sketch and show depths.

GROUND LEVEL

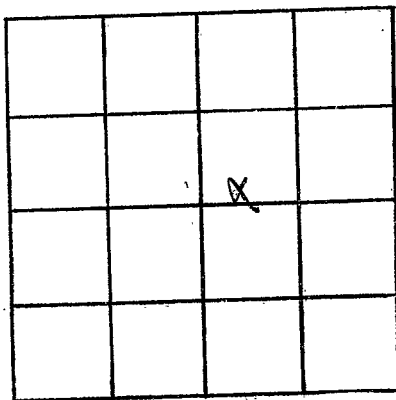

SECTION 28

Please indicate well location X.

ADDITIONAL INFORMATION

If more than one screen, show locations of each on sketch.