

Date  
 C 168  
 3-26-75

MISSISSIPPI  
 BOARD OF WATER COMMISSIONERS  
 416 North State Street  
 Jackson, Mississippi 39201

CODED

WATER WELL DRILLERS LOG


3-26-1975  
 date well completed

W.A. Mason  
 Water Well Contractor  
 firm name

Jate  
 county well located

LANDOWNER:	description of formations encountered	from	to
James Neal RFD, Coldwater, Miss. (mailing address)			
WELL LOCATION:	group	7	50
sec. 3 T 4 N R 6 E 15E (S) (W) 1 miles west of 309 Hwy (distance) (direction) (nearest town)	white clay	50	57
WELL PURPOSE: Home (home, irrigation, municipal, industrial)	white sand	57	153
WELL COMPLETION DATA:			
(1) diameter (inches) 4"			
(2) total depth (feet) 153'			
(3) static water level (feet) 87' below top of ground.			
(4) casing Plastic, 143' (material) (depth) 4" (size) if telescope see back.			
(5) screen 10' 143' (length) (depth to top) 4" Plastic (size) (material)			
(6) pump 1/2 5 (HP) (yield gpm) electric (type power)			
(7) electric log No (yes or no)			
(organization running log)			
(8) how well bottom plugged Cap on screen			
DRILLERS REMARKS:			


CODED

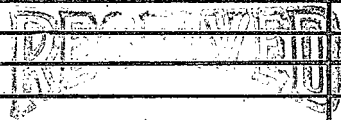

JUL 01 1975

If well telescopes please sketch and show depths.

GROUND LEVEL

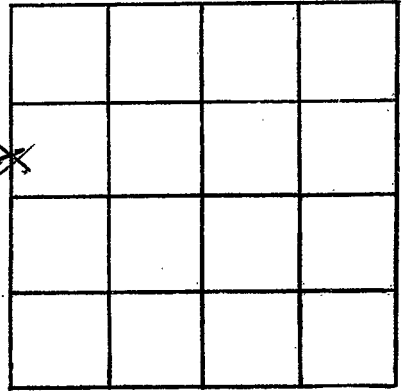

SECTION B

Please indicate well location X.

ADDITIONAL INFORMATION

If more than one screen, show locations of each on sketch.