




If well telescopes please sketch and show depths.

GROUND LEVEL

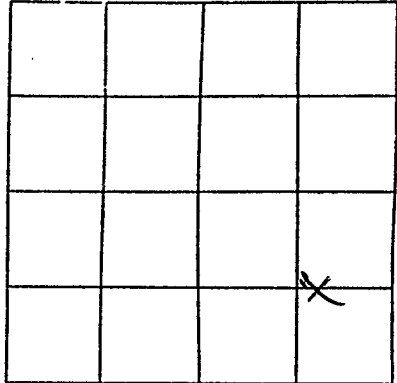

SECTION 6

Please indicate well location X.

|                     |               |               |
|---------------------|---------------|---------------|
| Pump Capacity (GPM) | No. of Stages | Setting Depth |
| 12                  | 11            | 100' FT.      |

PUMP TEST

Well yielded \_\_\_\_\_ GPM with  
a drawdown of \_\_\_\_\_ ft.  
after \_\_\_\_\_ hours of pumping

LOG DATA

TYPE OF LOG RUN (Circle One): No Log Run  
Electric, Gamma Ray, Density, Sonic, Neutron,  
Other (Describe) \_\_\_\_\_

Name of Organization Running Log

GEOLOGIC DATA (Office Use Only)

|               |               |                |              |
|---------------|---------------|----------------|--------------|
| Surface Elev. | Geologic Unit | Unit Thickness | Depth to Top |
| Subs. SWL     | Date          | Analysis       | Aquifer Test |

Driller's Remarks

3/4 - wmm-6.

If more than one screen,  
show location of each on sketch.