

**MISSISSIPPI DEPARTMENT OF ENVIRONMENTAL  
QUALITY**

Office of Land and Water Resources

P. O. Box 10631  
Jackson, MS 39289-0631  
**WATER WELL DRILLERS LOG**

COUNTY, WELL LOCATED <u>Itate</u>	
WELL NUMBER <u>C-195</u>	CODED
DATE WELL COMPLETED <u>1-22-04</u>	

PERMIT NUMBER
NAME OF DRILLING FIRM <u>Mason Water Wells</u>

NAME & MAILING ADDRESS OF LANDOWNER <u>Bob upchurch</u>			
<u>LOT 6 Springwood sub. coldwater ms. 38618</u>			
Latitude: Longitude:			
WELL LOCATION.	SEC <u>18</u>	TOWNSHIP <u>4<sup>N</sup> 6<sup>W</sup></u>	RANGE <u>6<sup>E</sup></u>
DISTANCE <u>3<sup>3</sup>/<sub>4</sub></u> Miles	DIRECTION <u>W</u>	NEAREST TOWN <u>of Hwy 305</u>	
OTHER LANDMARK			
WELL PURPOSE: <input checked="" type="checkbox"/> Home, <input type="checkbox"/> Irrigation, <input type="checkbox"/> Municipal, <input type="checkbox"/> Industrial, <input type="checkbox"/> Fish Pond, etc.			

PUMP DATA		
PUMP TYPE (Circle One): <input checked="" type="checkbox"/> Submersible, <input type="checkbox"/> Turbine, <input type="checkbox"/> Jet <input type="checkbox"/> Flowing Well, Other (Describe) _____		
POWER TYPE (Circle One): <input checked="" type="checkbox"/> Electric, <input type="checkbox"/> Tractor, <input type="checkbox"/> Diesel, <input type="checkbox"/> Gasoline, <input type="checkbox"/> Butane, Other (Describe) _____ H/P <u>3/4"</u>		
DESCRIPTION OF FORMATIONS ENCOUNTERED	FROM	TO
clay dirt.	0	15
gravel	15	40
Coarse wht sand.	40	90
hard rock	90	93
Blue clay	93	150
white sand	150	170
<b>RECEIVED</b>		
JAN 28 2004		
BY: OLWR		
<b>RECEIVED</b>		
JAN 26 2004		
BY: OLWR		
Top of Lap Pipe or Reduction in Casing		
FEET	IF TELESCOPED OR MORE THAN ONE SCREEN: USE BACK PAGE	

WELL DATA		
Well Depth <u>170'</u>	Casing Diameter (In.) <u>4"</u>	Casing Length (Ft.) <u>160'</u>
Type of Casing <u>PUC</u>	Hole Depth <u>170'</u>	Depth to Static Water Level <u>75'</u>
TYPE OF COMPLETION: (Circle One or More): <input checked="" type="checkbox"/> Gravel Packed, <input type="checkbox"/> Underreamed, <input type="checkbox"/> Telescoped, <input type="checkbox"/> Natural Development, <input type="checkbox"/> Open Hole, <input type="checkbox"/> Other (Describe) _____		
WELL GROUTED TO A DEPTH OF <u>10</u> FEET Type Grout (circle one): Cement, <input checked="" type="checkbox"/> Bentonite, or Mix		

SCREEN DATA		
Diameter - Inches <u>4"</u>	Length - Feet <u>10'</u>	Slot Size - Inches <u>#10</u>
Screen Type <u>PUC</u>	Depth to Bottom - Feet <u>170'</u>	

I certify that the well was drilled, constructed and completed in accordance with all applicable Requirements of the Mississippi Department of Environmental Quality and/or the Mississippi Department of Health regulations and state laws.


James W. Mason 0-620  
Signature of Licensed Driller and License No.

1-22-04  
Date

Additional Information Required On Back

If well telescopes please sketch and show depths.

GROUND LEVEL

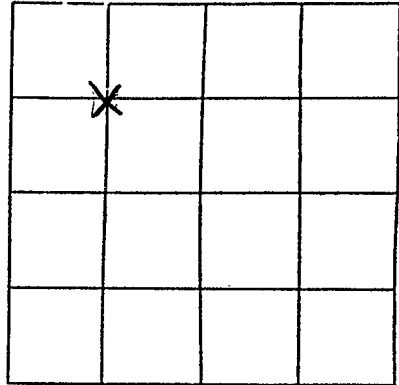

SECTION 18

Please indicate well location X.

Pump Capacity (GPM)	No. of Stages	Setting Depth
12	14	140' FT.

PUMP TEST

Well yielded \_\_\_\_\_ GPM with  
 a drawdown of \_\_\_\_\_ ft.  
 after \_\_\_\_\_ hours of pumping

LOG DATA

TYPE OF LOG RUN (Circle One): No Log Run.  
 Electric, Gamma Ray, Density, Sonic, Neutron,  
 Other (Describe) \_\_\_\_\_

Name of Organization Running Log

GEOLOGIC DATA (Office Use Only)

Surface Elev.	Geologic Unit	Unit Thickness	Depth to Top
Subs. SWL	Date	Analysis	Aquifer Test

Driller's Remarks

3/4 hp - 1000 G  
 \_\_\_\_\_  
 \_\_\_\_\_  
 \_\_\_\_\_  
 \_\_\_\_\_

If more than one screen,  
 show location of each on sketch.