


If well telescopes please sketch and show depths.

GROUND LEVEL

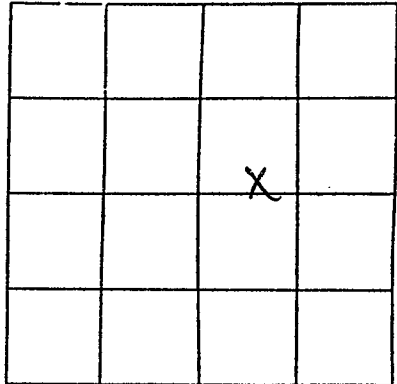

SECTION 6

Please indicate well location X.

Pump Capacity (GPM)	No. of Stages	Setting Depth
12	14	100' FT.

PUMP TEST

Well yielded _____ GPM with
a drawdown of _____ ft.
after _____ hours of pumping

LOG DATA

TYPE OF LOG RUN (Circle One): No Log Run
Electric, Gamma Ray, Density, Sonic, Neutron,
Other (Describe) _____

Name of Organization Running Log

GEOLOGIC DATA (Office Use Only)

Surface Elev.	Geologic Unit	Unit Thickness	Depth to Top
Subs. SWL	Date	Analysis	Aquifer Test

Driller's Remarks

3/4 hp - w-m-6 bladder

If more than one screen,
show location of each on sketch.