

# State Well Report

## Part 1

Mississippi Department of Environmental Quality  
Office of Land and Water Resources  
P.O. Box 10631  
Jackson, MS 39289-0631  
(601)961-5210  
(601)354-6938 (fax)

For Office Use Only:

Aquifer: \_\_\_\_\_  
Well #: C-223  
L. S. Elevation: \_\_\_\_\_  
E-log #: \_\_\_\_\_

County: TATE  
Permit #: \_\_\_\_\_  
Driller: BOB SMITH  
Date drilling completed: 9-16-05

State Law requires that this report be prepared by the driller in detail and filed with the Department within 30 days of completion of drilling of the well.

Well Owner Information	Well Location
Owner Name: <u>MR. GRAHAM</u>	Latitude: _____ Longitude: _____
Mailing Address: <u>6174</u> <u>PEDESTAL RD</u> <u>GRANTER, MS 3808</u> City State Zip Code	Method of Lat/Long (circle one): Conventional Survey, USGS quad, Hand-held GPS, Survey-grade GPS _____ 1/4 _____ 1/4 Sec <u>D-18</u> Twn <u>T4S</u> Rng <u>R6W</u>
Telephone No. <u>(662) 233-2137</u>	Distance <u>3</u> Miles Direction <u>NW</u> of Nearest Town <u>INDEPENDENCE</u>

### Well Data

Purpose of Well (circle one) Home Industrial Public Supply Irrigation Fish Culture Other: \_\_\_\_\_  
Date well drilling started: 9-16-05 Date well drilling completed: 9-16-05  
If flowing, method of flow regulation: Valve \_\_\_\_\_ Other (describe) \_\_\_\_\_  
Static Water Level: 80 feet above or below (circle one) land surface Date measured: 9-16-05  
Method of Measurement (circle one) steel tape electric tape air line other: \_\_\_\_\_  
Hole depth: 140 Well depth: 140 Well grouted to a depth of 10 feet  
Type of grout (circle one): Cement Bentonite Mix  
Casing length: 130 feet Casing diameter: 4 inches Type of casing: PVC  
Screen length: 10 feet Screen diameter: 4 inches Type of screen: PVC  
Screen slot size: 1/4" x 5/8" inches Setting depth: From 130 feet to 140 feet  
Type of completion (circle all applicable): Gravel packed Underreamed Telescoped Open hole Natural Development  
Other (describe): WASHER SCREEN  
Top of lap pipe or reduction in casing: \_\_\_\_\_ feet. If telescoped or more than one screen, describe on back of page  
Logs run (circle all applicable): No log run Electric Gamma Ray Density Sonic Neutron Other: \_\_\_\_\_  
Name of organization running log(s): \_\_\_\_\_

I certify that the well was drilled, constructed, and completed in accordance with all applicable requirements of the Mississippi Department of Environmental Quality and/or the Mississippi Department of Health regulations and state laws.

BOB SMITH 0645  
Print Name of Water Well Contractor and License No.

[Signature]  
Signature of Water Well Contractor

RECEIVED  
OCT 14 2005  
BY: OLWR

If well telescopes please sketch below and show depths.

C-223

Ground Level


Description of Formations Encountered

From To

Description of Formations Encountered	From	To
TOP SOIL	0	5
GRAVEL	5	40
WHITE SAND	40	90
WHITE SAND & CLAY	90	126
WHITE SAND	126	140

If more than one screen, show location of each on sketch

Sketch the property layout and include the following: 1) the well location; 2) any permanent structures on the property that may aid in locating the well; 3) any roads, power lines, or other items that may aid in locating the property and the well; 4) indicate direction.

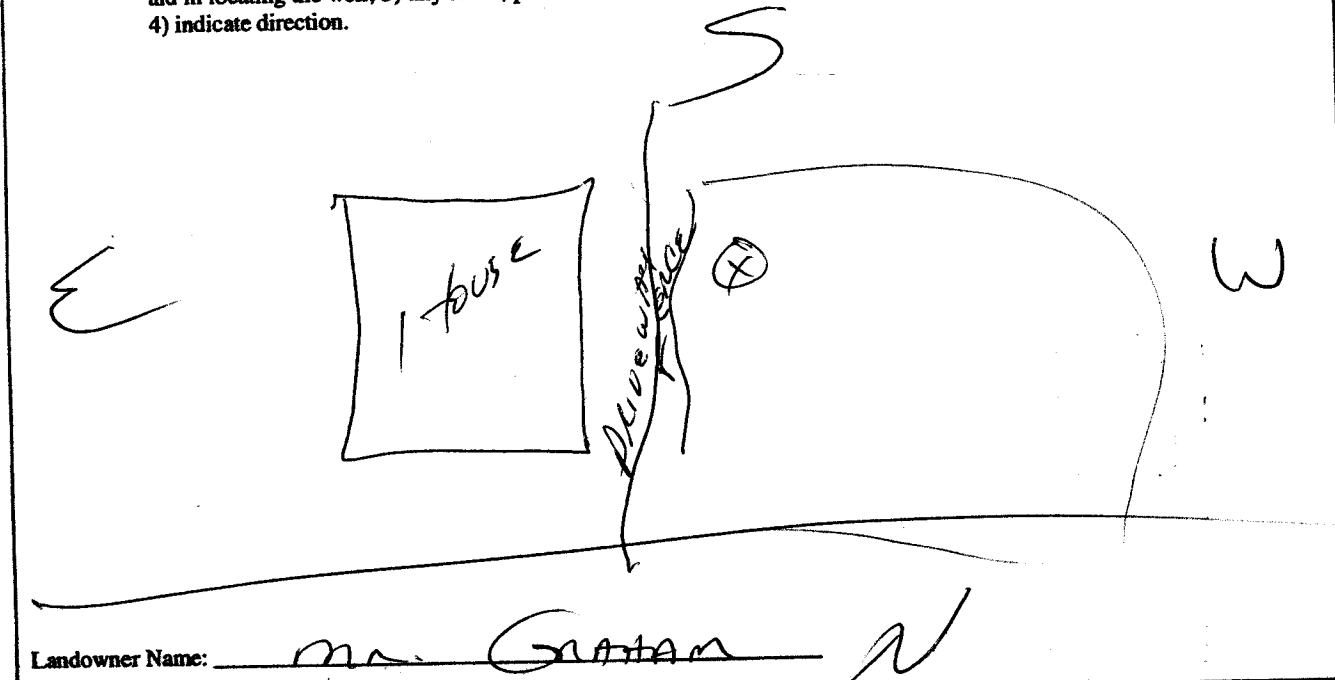

Landowner Name: Mr. GRAY

[Signature]  
Signature of Water Well Contractor

RECEIVED  
OCT 14 2005  
BY: OLWR

# STATE WELL REPORT

## Part 2

**Pump Installer's Completion Report**  
 Mississippi Department of Environmental Quality  
 Office of Land and Water Resources  
 P.O. Box 10631  
 Jackson, MS 39289-0631  
 (601)961-5210  
 (601)354-6938 (fax)

For Office Use Only:

Aquifer: \_\_\_\_\_

Well #: C-223

Elevation: \_\_\_\_\_

County: TATE

Permit #: \_\_\_\_\_

Driller: BOB SMITH

Date completed: 9-16-05

This report should be prepared by the pump installer in detail and filed with the Department within 30 days of the installation of pump.

Well Owner Information	Well Location
Owner Name: <u>AM. GUYMAN</u>	Latitude: _____ Longitude: _____
Mailing Address: <u>6174</u> <u>FORESTONE RD</u> <u>OSWATEL, MS 38618</u>	Method of Lat/Long (circle one): Conventional Survey, USGS quad, Hand-held GPS, Survey-grade GPS
City: _____ State: _____ Zip Code: _____	_____ 1/4 _____ 1/4 Sec. <u>D18</u> Twn <u>T4S</u> Rng <u>R6W</u>
Telephone No. <u>(662) 233-2137</u>	Distance _____ Direction _____ Nearest Town _____
	<u>3</u> Miles <u>NW</u> of <u>INDEPENDENCE</u>

Pump Type Circle one	Power Type Circle one
Air Lift      Jet <u>Submersible</u>	Diesel Engine      Gasoline Engine      Natural Gas
Bucket      Piston      Turbine	<u>Electric Motor</u> Hand      Tractor PTO
Centrifugal      Rotary      Flowing Well	Windmill      Other (specify): _____
Other (specify): _____	Horse Power Rating of Motor: <u>3/4</u>
Date Pump Installed: <u>9-16-05</u>	Setting Depth: <u>100</u> feet
Rated Pump Capacity: <u>12</u> Gallons Per Minute	Number of Stages: <u>12</u>

Pump Test Data	Method of Measuring Water Level Circle one
Date Well Tested: <u>9-16-05</u>	Air Line <u>Electric Measuring Line</u> Steel Tape
Static Water Level (A): <u>80</u> Feet Below Land Surface	Other (specify): _____
Pumping Water Level (B): <u>84</u> Feet Below Land Surface	For flowing well, measured shut in head: _____ feet
Drawdown [(B) - (A)]: <u>4</u> Feet Below Land Surface	Well yielded <u>14</u> GPM with a drawdown of
Test Pumping Rate: <u>14</u> Gallons Per Minute	<u>4</u> feet after _____ hours of pumping
Duration of Pump Test (minimum 4 hours): _____ hours	

I HEREBY CERTIFY that the above statements are true to the best of my knowledge.

<u>Bob Smith</u> Print Name of Pump Installer and License No. (if applicable)	 Signature of Pump Installer
----------------------------------------------------------------------------------	---------------------------------

RECEIVED  
 OCT 14 2005  
 BY: OLWR