County: Tate Part 1 – Permit #:	State Well Report Part 1 – Driller's Log Mississippi Department of Environmental Quality Office of Land and Water Resources P.O. Box 10631 Jackson, MS 39289-0631 (601)961-5210 (601)354-6938 (fax)					
	State Law requires that this report be prepared by the license holder responsible for the work and filed with the Department at the above address within 30 days of completion of drilling of the well or borehole.					
Information on Well Owner		orehole Location				
(Landowner if borehole is not for a water well)	Latitude 34 . 44 . 826	" Longitude: 89.49,)65				
Owner Name Clork Scruggs	Method of Lat/Long (circle or	<u>5</u> " Longitude: <u>89.949</u> , <u>365</u> ne): Conventional Survey, 45				
Mailing Address: <u>LOT</u> 3		GP9, Survey-grade GPS				
Greer rd						
	<u>ا ساکہ ساد</u>	Twn 45 Rng 6W				
Coldwoter Ms 38618 City State Zip Code	Distance Direction	of Nearest Town				
Telephone No. (642) 233 4096	<u>3</u> Miles \mathcal{W}	of CEREMENTER Level				
Date drilling started: 1-12-06 Date drilling completed: 1-12-06 Hole depth: 95 Hole diameter: 8' Location of the source of any surface water used for drilling: 14 Method of dosing and volume of Chlorine used in drilling and development:						
Purpose of Well (check one): Home / Industrial Public Supp	oly Irrigation Fish Culture	Other:				
If a flowing well, method of flow regulation: Valve $\underline{~~}\mathcal{A}$	Other (describe)					
\sim						
Static Water Level:feet above of below brircle one) land surface Date measured:						
Method of Measurement (circle one) steel tape electric tape air line other: <u>String (weight</u>						
Well depth: <u>()</u> Well grouted to a depth of <u>()</u> feet Type of grout (circle one): Neat Cement Bentonite Mix						
Casing length: <u>85</u> feet Casing diameter: <u>4</u> inches Type of casing: <u>put</u>						
Screen length:feet Screen diameter:inches Type of screen:						
Screen length: 10 feet Screen diameter: 4 inches Type of screen: $\rho \checkmark C$ Screen slot size: , 010 inches Setting depth: From $\mathcal{B5}$ feet to $\mathcal{75}$ feet						
Type of completion (circle all applicable): Gravel packed Underreamed Telescoped Open hole Natural Development						
Other (describe):						
Top of lap pipe or reduction in casing:feet. If telescoped or more than one screen, describe on next page						
· · · · · · · · · · · · · · · · · · ·		Form: OLWR-SWR-				

2. 4

FEB 1 0 2006 BY: OLWR

.

230


The sketch below only required for water wells

	wells and boreho
If well telescopes, show depths on sketch.	
Ground Level	Description of Form
	- Clay de
	white
	······

<u>Description of formations encountered must be provided for all</u> wells and boreholes, unless specifically exempted by regulations

Description of Formations Encountered	From (depth)	To (depth)
cloy dirt	Ground Level	40
white soud	40	95
		1
		+
		+
	+	1
		<u> </u>
		<u> </u>

If more than one screen, show location of each on sketch

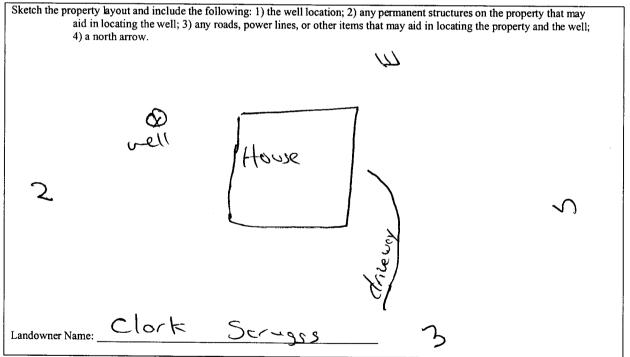

Form: OLWR-SWR-1A

I certify that the well/borehole was drilled, constructed, and completed in accordance with all applicable requirements of the Mississippi Department of Environmental Quality and the Mississippi Department of Health regulations, if applicable, and state

2-4-06

laws. Jones W. Masa

N

Print Name of Responsible Licensee and License No.

ense No. Date

Signature of Licensee RECEIVED

FEB 1 0 2006 BY: OLWR

STATE WELL REPORT					
County: Tate	Part 2		For Office Use Only:		
Permit #:	Pump Installer's Completion Report Mississippi Department of Environmental Quality				
Driller: Jones W. Mason	Office of Land and Water Resources		Aquifer:		
Date completed: 1-30-06	P.O. Box 10631 Jackson, MS 39289-0631		Well #: <u>(1-230</u>		
	(601)961-5210 (601)354-6938 (fax)		Elevation:		
		. ,			
This part of the report must be completed by a licensed water well contractor or a licensed pump installer. A copy of Part 1 of the report must be attached and both parts filed with the Department at the above address within 30 days of well completion.					
			Location		
Owner Name: Clork Scr.	Latitude: 34.44. 820		Longitude: 89.49.762		
Mailing Address: LOT 3	Method of Lat/Long (check on		e): Conventional Survey,		
Greer rd	,,,,		GPS, Survey-grade GPS		
City State	38418	<u>38618</u> <u>Stuly Sw 1/2 Sec 10 T</u>			
City State	Zip Code	Distance Direction Nearest Town			
Telephone No. (662, 233-40	$96 3_{\text{Miles}} \omega_{\text{of}}$		ren gorden		
Pump Type Power Type		ver Tyne			
Circle one		Power Type Circle one			
Air Lift Jet	Submersible	Diesel Engine Gasolin	e Engine Natural Gas		
Bucket Piston	Turbine	Electric Motor Hand	Tractor PTO		
Centrifugal Rotary	Flowing Well	Windmill Other (s	specify):		
Other (specify): Horse I		Horse Power Rating of Motor: <u>314</u>			
Date Pump Installed: $1 - 38 - 66$ Setting Depth:		Setting Depth:	feet		
Rated Pump Capacity: (Ə	Gallons Per Minute	Number of Stages://			
Pump Test Data		Method of Mea	asuring Water Level		
Date Well Tested: 1-30-06		Cir	rcle one		
		Air Line Electric Meas			
Pumping Water Level (B): $\[A]{A}\]$ Feet Below Land Surface		Other (specify): String (weight			
		For flowing well, measured shu	ut in head: r^{A} feet		
10		Well yielded GPM with a drawdown of			
Duration of Pump Test (minimum 4 hours):					
I HEREBY CERTIFY that the above statements are true to the best of my knowledge.					
- bres w. Masu Como w. More					
Print Name of Pump Installer and License No. (if applicable) Signature of Pump Installer					

٦

÷

Form: OLWR-SWR-1B RECEIVED FEB 1 0 2006 BY: OLWR