	State Well Report	
	-	For Office Use Only:
County: TGte	Part 1 – Driller's Log	Tor Office one only.
	Mississippi Department of Environmental Quality	Aquifer:
Permit #:	Office of Land and Water Resources	well #: E-242
Driller: Jores w. Majon	P.O. Box 10631	wen # U
	Jackson, MS 39289-0631	L. S. Elevation:
Date drilling completed: 7-32-06	(601)961-5210	
	(601)354-6938 (fax)	E-log #:

s 4

,

State Law requires that this report be prepared by the license holder responsible for the work and filed with the Department at the above address within 30 days of completion of drilling of the well or borehole.
Information on Well Owner
Well or Borehole Location

Information on Well Owner	Well or Borehole Location		
(Landowner if borehole is not for a water well)	2		
Owner Name Clork Scruggs	Latitude: $34 \cdot 44 \cdot 431$ " Longitude: $89 \cdot 49 \cdot 727$ " 25 Method of Lat/Long (circle one): Conventional Survey, 43		
Mailing Address: しめて ら	USGS quad, (Hand-held GPS.) Survey-grade GPS		
Greer 1d.			
City State Zip Code	<u>Sw 1/2 Sw 1/2 Sec 9 Twn 45 Rng 6w</u>		
City State Zip Code	Distance Direction Nearest Town <u>(8 Miles r of giverhil)</u>		
Telephone No. (662-233-2003	VIVIVIVI		
Well / Bore	hole Data		
Date drilling started: $\frac{\gamma - 2 - 0 \zeta}{\gamma - 2 - 0 \zeta}$ Date drilling completed: $\frac{\gamma - 2 - 2 - 2 \zeta}{\gamma - 2 - 2 - 2 - 2 \zeta}$	$\frac{c_6}{100}$ Hole depth: $\frac{95}{100}$ Hole diameter: $\frac{6314}{100}$		
Location of the source of any surface water used for drilling:M Method of dosing and volume of Chlorine used in drilling and devel	lopment: MA		
Logs run (circle all applicable). No log run Electric Gamma Ray Name of organization running log(s):	Density Sonic Neutron Other:		
Purpose of borehole (check one): Water Well Geotechnical/Geol	ogical Investigation Ground Source Heat Pump		
Seismic Survey Other (describe If drilling is not related to water well constructio	e)		
Purpose of Well (check one): Home \smile Industrial Public Supply Irrigation Fish Culture Other:			
If a flowing well, method of flow regulation: Valve C			
Static Water Level:feet above of below scircle one)	land surface Date measured: 7 - 22 - 06		
Method of Measurement (circle one) steel tape electric tape air line other: String (weight			
Well depth: 95 Well grouted to a depth of 10 feet Type of grout (circle one): Neat Cement Bentonite Mix			
Casing length: 85 feet Casing diameter: 4 inches Type of casing: put			
Screen length: feet Screen diameter: inches Type of screen:			
Screen slot size: <u>, O 10</u> inches Setting depth: From <u>85</u> feet to <u>95</u> feet			
Type of completion (circle all applicable): Gravel packed Under	rreamed Telescoped Open hole Natural Development		
Other (describe):	~~~4		
Top of lap pipe or reduction in casing:feet. If te	elescoped or more than one screen, describe on next page		
	Form: OLWR-SWR-1A		
	the Thermony of the second		

SFF 1:2005 BY OLVVE

BYCONWR


Description of formations encountered must be provided for all

The sketch below only required for water wells

If well telescopes, show depths on sketch. Ground Level

equinea for water weus_	wells and boreholes, unless specifically exempted by regulations		
depths on sketch.			
7	Description of Formations Encountered	From (depth) 7 Ground Level	Fo (depth)
	clay dirt.		
	white clay	30	35
	while soud.	05	95
	·····		
			<u> </u>

If more than one screen, show location of each on sketch

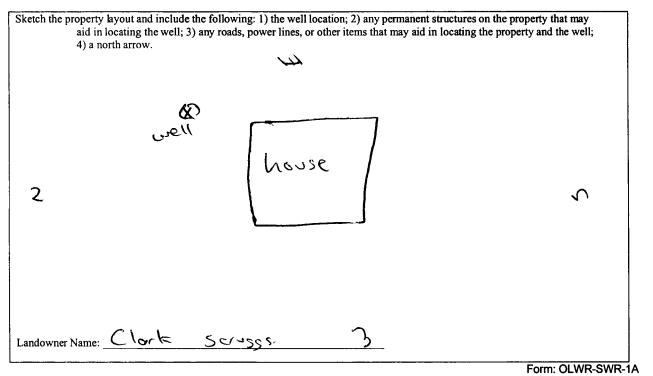

I certify that the well/borehole was drilled, constructed, and completed in accordance with all applicable requirements of the Mississippi Department of Environmental Quality and the Mississippi Department of Health regulations, if applicable, and state laws.

JonesW. MajorD-6208-17-00Print Name of Responsible Licensee and License No.Date Signature of Licensee RECEVED SEP 0 : 2008

STATE WELL REPORT				
County: Tate	Part 2 Pump Installer's Completion Report	For Office Use Only:		
Permit #:	Mississippi Department of Environmental Quality Office of Land and Water Resources	Aquifer:		
Driller: Jones w-Masa	P.O. Box 10631	C = 2U2		
Date completed: 7-33-06	Jackson, MS 39289-0631 (601)961-5210	Well #: $\underline{C} = \alpha q \alpha$		
Copy information from block on Part 1	(601)354-6938 (fax)	Elevation:		

•

Г

 This part of the report must be completed by a licensed water well contractor or a licensed pump installer. A copy of Part 1 of the report must be attached and both parts filed with the Department at the above address within 30 days of well completion.

 Well Owner Information
 Well Location

wen Owner Information	W Ch Location		
Owner Name: Clark Scruggs Mailing Address: LOT 6	Latitude: 34.44.44 Longitude: 29.49.72 25 Method of Lat/Long (check one): Conventional Survey,		
greer rd	USGS quad, Hand-held GPS, Survey-grade GPS		
City State Zip Code	<u>Sw 1/2 SW 1/2 Sec 9 T 45 R GW</u>		
	Distance Direction Nearest Town		
Telephone No. (162 233-2003	18 Miles N of girdgerhill		

Pump Type Circle one		Power Type Circle one			
Air Lift	Jet	Submersible	Diesel Engine	Gasoline Engine	Natural Gas
Bucket	Piston	Turbine	Electric Motor	Hand	Tractor PTO
Centrifugal	Rotary	Flowing Well	Windmill	Other (specify):	
Other (specify):			Horse Power Rating	; of Motor:3 (-	4
Date Pump Installed:	7-22-00	5	Setting Depth:	40	feet
Rated Pump Capacity	: <u>ر</u> ح	Gallons Per Minute	Number of Stages:	11	

Pump Test Data	Method of Measuring Water Level		
Date Well Tested: 7-79-06	Circle one		
Static Water Level (A): $\partial \mathcal{A}$ Feet Below Land Surface	Air Line Electric Measuring Line Steel Tape		
	Other (specify): String (weight		
Pumping Water Level (B): <u>VA</u> Feet Below Land Surface			
Drawdown $[(B) - (A)]$: $\swarrow A$ Feet Below Land Surface	For flowing well, measured shut in head:feet		
Test Pumping Rate: (2 Gallons Per Minute	Well yielded $l \supset GPM$ with a drawdown of		
Duration of Pump Test (minimum 4 hours): <u>24</u> hours	$\underline{N,4}$ feet after $\underline{\partial 4}$ hours of pumping		

I HEREBY CERTIFY that the above statements are true to the best of	of my knowledge.	
Jones W. Moson	Jews w. Man	
Print Name of Pump Installer and License No. (if applicable)	Signature of Pump Installer	MEMEN
		Form: OLWR-SWR-1B

SEP 1 2006 BY: OLVVR