

State Well Report

Part 1 - Driller's Log

Mississippi Department of Environmental Quality
Office of Land and Water Resources
P.O. Box 10631
Jackson, MS 39289-0631
(601)961-5210
(601)354-6938 (fax)

For Office Use Only:

Aquifer: _____
Well #: C-258
L. S. Elevation: _____
E-log #: _____

County: TATE
Permit #: _____
Driller: FANNING FOR L
Date drilling completed: 3-22-07
Well # 2

State Law requires that this report be prepared by the license holder responsible for the work and filed with the Department at the above address within 30 days of completion of drilling of the well or borehole.

Information on Well Owner

(Landowner if borehole is not for a water well)

Owner Name: RAY FREEMAN
Mailing Address: BETT R K
Coldwater MS
City State Zip Code
Telephone No. () _____

Well or Borehole Location

Latitude: _____ Longitude: _____
Method of Lat/Long (circle one): Conventional Survey
USGS quad, Hand-held GPS, Survey-grade GPS
____ 1/4 ____ 1/4 Sec 2 Twn 419 Rng 6W
Distance Direction Nearest Town
3 Miles N of BETT

Well / Borehole Data

Date drilling started: 3-22-07 Date drilling completed: 3-22-07 Hole depth: 110 Hole diameter: 6 3/8"

Location of the source of any surface water used for drilling: well
Method of dosing and volume of Chlorine used in drilling and development: 2 GAL CLOROX

Logs run (circle all applicable): No log run Electric Gamma Ray Density Sonic Neutron Other: _____
Name of organization running log(s): _____
(Attach copy of log to this report)

Purpose of borehole (check one): Water Well Geotechnical/Geological Investigation _____ Ground Source Heat Pump _____
Seismic Survey _____ Other (describe) _____

If drilling is not related to water well construction, skip the remainder of this block

Purpose of Well (check one): Home Industrial _____ Public Supply _____ Irrigation _____ Fish Culture _____ Other: _____

If a flowing well, method of flow regulation: Valve _____ Other (describe) _____

Static Water Level: 30 feet above or below (circle one) land surface Date measured: 3-22-07

Method of Measurement (circle one) steel tape electric tape air line other: _____

Well depth: 110 Well grouted to a depth of 10 feet Type of grout (circle one): Neat Cement Bentonite Mix

Casing length: 20 feet Casing diameter: 4 inches Type of casing: PVC

Screen length: 10 feet Screen diameter: 4 inches Type of screen: 5107 PVC

Screen slot size: .013 inches Setting depth: From 100 feet to 110 feet


Type of completion (circle all applicable): Gravel packed Underreamed Telescoped Open hole Natural Development

Other (describe): _____

Top of lap pipe or reduction in casing: _____ feet. *If telescoped or more than one screen, describe on next page*

The sketch below only required for water wells

If well telescopes, show depths on sketch.

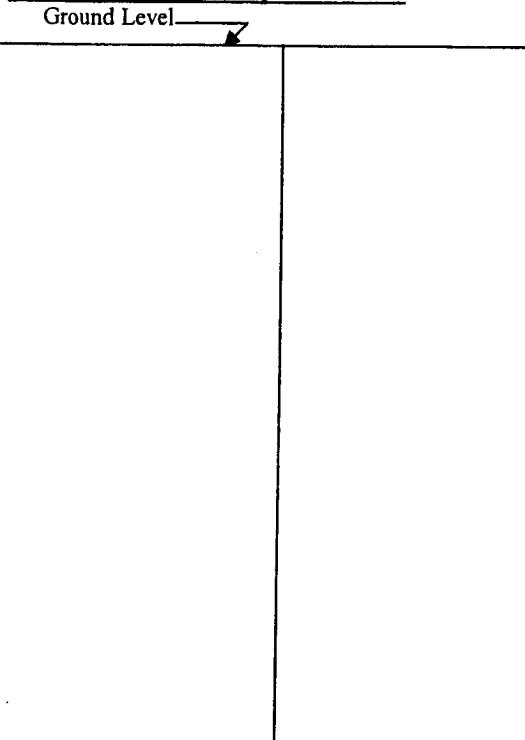


Description of formations encountered must be provided for all wells and boreholes, unless specifically exempted by regulations

Description of Formations Encountered	From (depth)	To (depth)
	Ground Level	
DIAT-	0	10
SAND	10	20
Mix w/clay/w sand	20	40
w/sand	40	110

If more than one screen, show location of each on sketch

Sketch the property layout and include the following: 1) the well location; 2) any permanent structures on the property that may aid in locating the well; 3) any roads, power lines, or other items that may aid in locating the property and the well; 4) a north arrow.

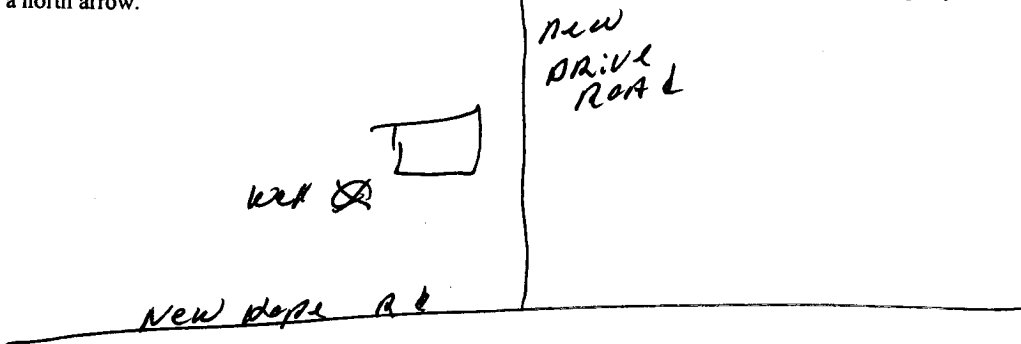

Landowner Name: RAY FREEMAN

I certify that the well/borehole was drilled, constructed, and completed in accordance with all applicable requirements of the Mississippi Department of Environmental Quality and the Mississippi Department of Health regulations, if applicable, and state laws.

Print Name of Responsible Licensee and License No. FRANK LANGFORD 0-622

Date 4-7-07

Signature of Licensee Frank Langford

RECEIVED APR 12 2007

STATE WELL REPORT

Part 2

Pump Installer's Completion Report
 Mississippi Department of Environmental Quality
 Office of Land and Water Resources
 P.O. Box 10631
 Jackson, MS 39289-0631
 (601)961-5210
 (601)354-6938 (fax)

County: TATA
 Permit #: _____
 Driller: FLANAGAN
 Date completed: 3-22-07
well # 2
Copy information from block on Part 1

For Office Use Only:

Aquifer: _____
 Well #: C-258
 Elevation: _____

This part of the report must be completed by a licensed water well contractor or a licensed pump installer. A copy of Part 1 of the report must be attached and both parts filed with the Department at the above address within 30 days of well completion.

Well Owner Information	Well Location
Owner Name: <u>RAY FREEMAN</u>	Latitude: _____ Longitude: _____
Mailing Address: <u>BETT Hk</u>	Method of Lat/Long (check one): <u>Conventional Survey</u>
<u>Coldwater MS</u>	USGS quad _____, Hand-held GPS _____, Survey-grade GPS _____
City State Zip Code	_____ 1/4 _____ 1/4 Sec <u>2</u> T <u>43</u> R <u>6W</u>
Telephone No. (____) _____	Distance Direction Nearest Town
	_____ Miles , _____ of _____

Pump Type Circle one	Power Type Circle one
Air Lift Jet <u>Submersible</u>	Diesel Engine Gasoline Engine Natural Gas
Bucket Piston Turbine	<u>Electric Motor</u> Hand Tractor PTO
Centrifugal Rotary Flowing Well	Windmill Other (specify): _____
Other (specify): _____	Horse Power Rating of Motor: <u>3/4</u>
Date Pump Installed: <u>3-22-07</u>	Setting Depth: <u>80</u> feet
Rated Pump Capacity: <u>15 ft</u> Gallons Per Minute	Number of Stages: <u>12</u>

Pump Test Data	Method of Measuring Water Level Circle one
Date Well Tested: <u>3-22-07</u>	Air Line Electric Measuring Line <u>Steel Tape</u>
Static Water Level (A): <u>30</u> Feet Below Land Surface	Other (specify): _____
Pumping Water Level (B): <u>30</u> Feet Below Land Surface	For flowing well, measured shut in head: _____ feet
Drawdown [(B) - (A)]: <u>0</u> Feet Below Land Surface	Well yielded <u>15 ft</u> GPM with a drawdown of
Test Pumping Rate: <u>15 ft</u> Gallons Per Minute	_____ feet after <u>4</u> hours of pumping
Duration of Pump Test (minimum 4 hours): <u>4</u> hours	

I HEREBY CERTIFY that the above statements are true to the best of my knowledge.

Print Name of Pump Installer and License No. (if applicable)

Signature of Pump Installer