| | State Well Report | |
|----------------------------------|---|----------------------|
| TI | | For Office Use Only: |
| County: /ate | Part 1 – Driller's Log | |
| | Mississippi Department of Environmental Quality | Aquifer: |
| Permit #: | Office of Land and Water Resources | well # C-263 |
| Driller: James w. Mason | P.O. Box 10631 | Well #: <u> </u> |
| | Jackson, MS 39289-0631 | L. S. Elevation: |
| Date drilling completed: 7-21-07 | (601)961-5210 | |
| | (601)354-6938 (fax) | E-log #: |

٦,

۰.,

State Law requires that this report be prepared by the license holder responsible for the work and filed with the Department at the above address within 30 days of completion of drilling of the well or borehole.

| Information on Well Owner | Well or Borehole Location | | | | |
|--|---|--|--|--|--|
| (Landowner if borehole is not for a water well) | 3.1 | | | | |
| Owner Name Johnother Shippley | Latitude: $34 \circ 44$, 553 Longitude: $89 \circ 48$, 310 Method of Lat/Long (circle one): Conventional Survey, | | | | |
| Mailing Address: 324 wokefeild rd. | USGS quad, Hand-held GPS, Survey-grade GPS | | | | |
| | | | | | |
| | NE 1/2 NW 1/4 Sec 14 Twn 45 Rng 6W | | | | |
| City State Zin Code | | | | | |
| City State Zip Code | Distance Direction Nearest Town | | | | |
| Telephone No. (662) 233 - 47 64 | -10/4 Milles 01 000 vereita | | | | |
| | | | | | |
| Well / Borehole Data | | | | | |
| Date drilling started: <u>7-21-07</u> Date drilling completed: <u>7-24-0</u> | Hole depth: 155^{\prime} Hole diameter: $6^{3/4}$ | | | | |
| Location of the source of any surface water used for drilling: | | | | | |
| Location of the source of any surface water used for drilling: | | | | | |
| | | | | | |
| Logs run (circle all applicable): No log run Electric Gamma Ray Density Sonic Neutron Other: | | | | | |
| | | | | | |
| Purpose of borehole (check one): Water Well 🟒 Geotechnical/Geological Investigation Ground Source Heat Pump | | | | | |
| | | | | | |
| Seismic SurveyOther (<i>describe</i>) | | | | | |
| If drilling is not related to water well construction, skip the remainder of this block | | | | | |
| Purpose of Well (check one): Home 🗹 Industrial Public Supply Irrigation Fish Culture Other: | | | | | |
| If a flowing well, method of flow regulation: Valve Other (describe) | | | | | |
| Static Water Level: <u>36</u> feet above or felow (circle one) land surface Date measured: <u>7-34-07</u> | | | | | |
| Method of Measurement (circle one) steel tape electric tape air line other: String / weight | | | | | |
| Well depth: 155 Well grouted to a depth of 10 feet Type of grout (circle one): Neat Cement Bentonite Mix | | | | | |
| Casing length: 145 feet Casing diameter: 4 inches Type of casing: puc | | | | | |
| Screen length: <u>10</u> feet Screen diameter: <u>4</u> inches Type of screen: <u>pvc</u> | | | | | |
| Screen slot size: .010 inches Setting depth: From 145 feet to 155 feet | | | | | |
| Type of completion (circle all applicable): Gravel packed Underreamed Telescoped Open hole Natural Development | | | | | |
| Other (describe): | | | | | |
| Top of lap pipe or reduction in casing: feet. If telescoped or more than one screen, describe on next page | | | | | |
| L | Form: OLWR-SWR-1/ | | | | |
| | | | | | |

AUG 2 0 2007 BY: OLVVR

C-263

The sketch below only required for water wells


If well telescopes, show depths on sketch. Ground Level

• 1

Description of formations encountered must be provided for all wells and boreholes, unless specifically exempted by regulations

| Description of Formations Encountered | From (depth) Ground Level | |
|---------------------------------------|---------------------------|----------|
| clay dirt. | | 15 |
| whete clay | 15 | 3 |
| white sand | 35 | 15 |
| | | |
| · · · · · · · · · · · · · · · · · · · | - | |
| | | |
| | | |
| | | |
| | | |
| | | <u> </u> |
| | | <u> </u> |
| | | |
| | | |
| | | |
| ······ | | |
| | | 1 |
| | | |
| | | |
| | | |
| | _ | <u> </u> |
| | | |
| | | |
| | - | 1 |
| | | |
| | | |
| | | |
| | | |
| | · | + |
| | | |

If more than one screen, show location of each on sketch

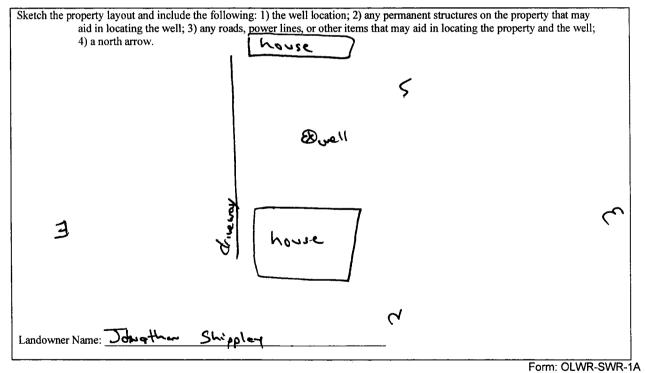

I certify that the well/borehole was drilled, constructed, and completed in accordance with all applicable requirements of the Mississippi Department of Environmental Quality and the Mississippi Department of Health regulations, if applicable, and state

Date

laws. َک . Mason 0-670 8-13-07

Print Name of Responsible Licensee and License No.

Signature of Licensee

AUG 2 0 2007 BY: OLWR

| STATE WELL REPORT | | | | |
|---|--|--|--|--|
| County: Tate Paraller's Permit #: | For Office Use Only: Aquifer: Aquifer: Aquifer: Well #: <u>C-263</u> Well #: <u>C-263</u> Elevation: Elevation: Contractor or a licensed pump installer. A copy of Part 1 of the | | | |
| Caldwoler ny <u>38418</u> City State Zip Code Telephone No. (662) 233- 4764 | USGS quad, Hand-held GPS_, Survey-grade GPS NE_ 4NW 4 Sec 14 T 4s R 6W Distance Direction Nearest Town 13/4 Miles W of Wokefeild. | | | |
| Pump Type Circle one Air Lift Jet Bucket Piston Centrifugal Rotary Flowing Well Other (specify): | Power Type Circle one Diesel Engine Gasoline Engine Natural Gas Electric Motor Hand Tractor PTO Windmill Other (specify): | | | |
| Date Pump Installed: フーライーの Rated Pump Capacity: しみ Gallons Per Minute | Setting Depth: & | | | |
| Pump Test DataDate Well Tested: $7 - \partial - 4 - o 7$ Static Water Level (A): 3ζ Feet Below Land SurfacePumping Water Level (B): NA Feet Below Land SurfaceDrawdown [(B) - (A)]: NA Feet Below Land SurfaceTest Pumping Rate:(a)Gallons Per MinuteDuration of Pump Test (minimum 4 hours): $\partial - 4$ | Method of Measuring Water Level Circle one Air Line Electric Measuring Line Steel Tape Other (specify): String [weight] Steel Tape For flowing well, measured shut in head: | | | |

. .

- + x

I HEREBY CERTIFY that the above statements are true to the best of my knowledge.

 Jack
 Jack

AUG 2 0 2007 BY: OLWR