

State Well Report

Part 1

Mississippi Department of Environmental Quality
Office of Land and Water Resources
P.O. Box 2309
Jackson, MS 39225

For Office Use Only

Aquifer: _____
Well #: C-291
L.S. Elevation: _____
E-Long #: _____

County: TATE
Permit #: _____
Driller: BOB SMITH
Date drilling complet: 10-26-08

State Law requires that this report be prepared by the driller in detail and filed with the Department within 30 days of completion of drilling of the well.

Well Owner Information	Well Location
Owner Name: <u>ROBERT FOSTER</u>	Latitude: _____ "Longitude: _____"
Mailing Address: <u>4314 KENBROOK DR.</u> <u>HANNAH, MS 38637</u>	Method of Lat/Long (circle one): Conventional Survey, USGS quad, Hand-held GPS, Survey-grade GPS
City: _____ State: _____ Zip Code: _____	<u>1/4</u> <u>1/4</u> Sec <u>2-6</u> Twn <u>14S</u> Rng <u>R6W</u>
Telephone No. <u>(901) 949-7400</u>	Distance: <u>5</u> Miles Direction: <u>N</u> of Nearest Town: <u>POAGVILLE</u>

Well Data

Purpose of Well (circle one) Home Industrial Public Supply Irrigation Fish Culture Other _____

Date well drilling started: 10-26-08 Date well drilling completed: 10-26-08

If flowing, method of flow regulation: Valve _____ Other (describe) _____

Static Water Level: 60 feet above or below (circle one) land surface Date measured: 10-26-08

Method of Measurement (circle one) steel tape electric tape air line other: LIME + WEIGHT

Hole Depth: 195 Well depth: 195 Well grouted to a depth of 10 feet

Type of grout: (circle one) Cement Bentonite Mix

Casing length: 175 feet Casing diameter: 4 inches Type of casing: PVC

Screen length: 20 feet Screen diameter: 4 inches Type of screen: PVC

Screen slot size: 10 mesh inches Setting depth: From 175 feet to 195 feet

Type of completion (circle all applicable):
Gravel packed Underreamed Telescoped Open hole Natural Development
Other (describe): WASHED SAND

Top of lap pipe or reduction casing: _____ feet. If telescoped or more than one screen, describe on back

Logs run (circle one): No log run Electric Gamma Ray Density Sonic Neutron Other: _____

Name of organization running log(s): _____

I certify that the well drilled, constructed, and completed in accordance with all applicable requirements of the Mississippi Department of Environmental Quality and/or the Mississippi Department of Health regulations and state laws:


BOB SMITH 0645
Print name of Water Contractor and License No.

[Signature]
Signature of Water Well Contractor

RECEIVED
NOV 24 2008
BY: OLWR

C-291

Ground Level

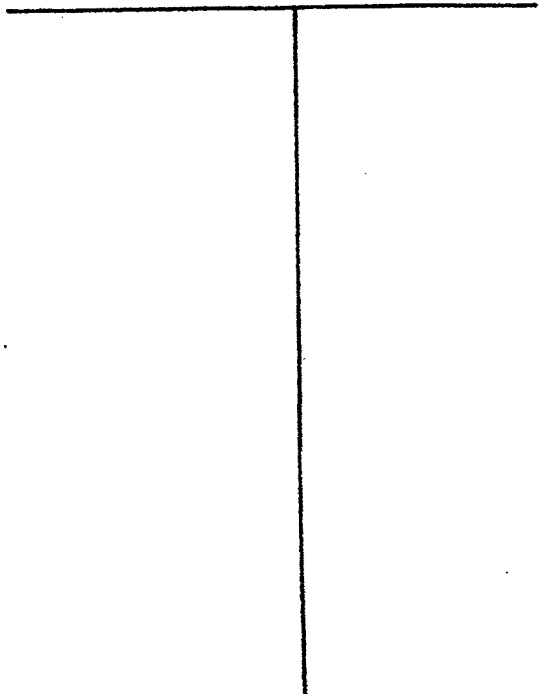

Description of Formations Encountered


From

To

Description of Formations Encountered	From	To
TOP SOIL	0	5
BROWN CLAY	5	27
GRAVEL	27	60
GREY CLAY	60	120
WHITE CLAY & SAND	120	170
WHITE SAND	170	195

If more than one screen, show location of each on sketch

Sketch the property layout and include the following: 1) the well location; 2) any permanent structures on the property that may aid in locating the well; 3) any roads, power lines, or other items that may aid in locating the property and the well; 4) indicate direction.

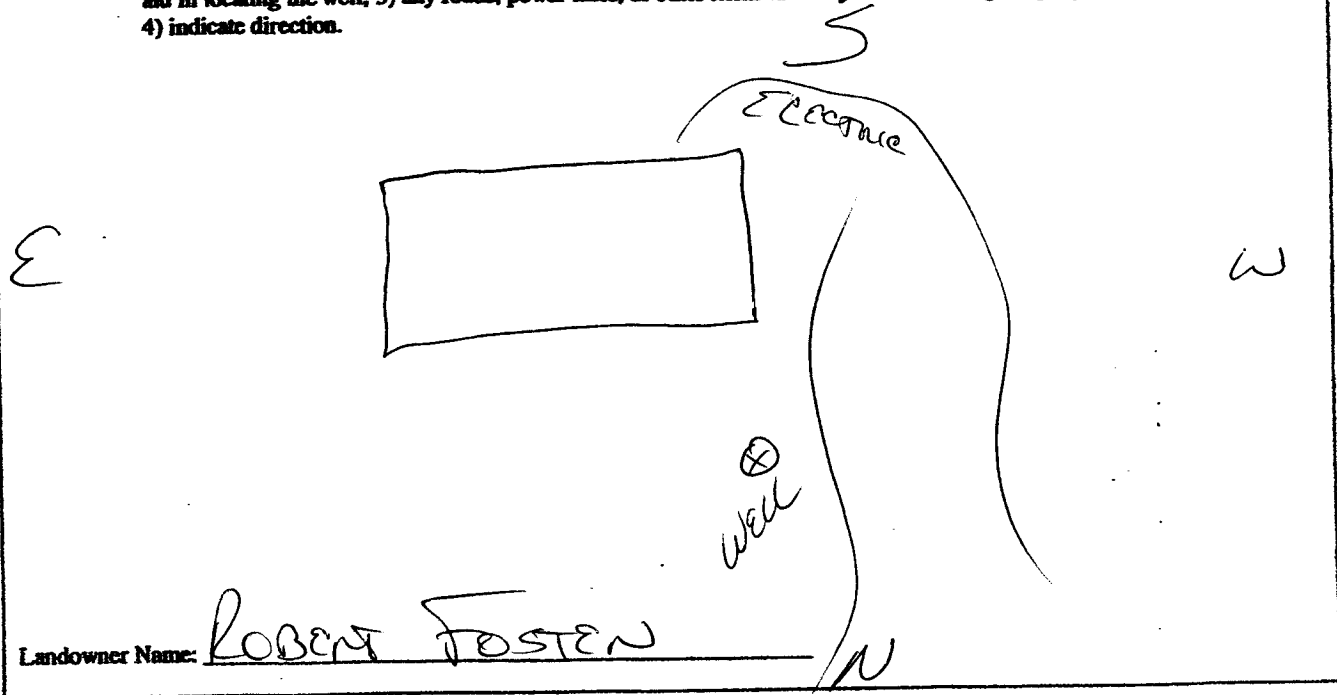

Landowner Name: ROBERT FOSTEN

[Signature]
Signature of Water Well Contractor

REC'D

M'

BY.

State Well Report

Part 2

Pump Installer's Completion Report

Mississippi Department of Environmental Quality

Office of Land and Water Resources

P.O. Box 2309

Jackson, MS 39225

For Office Use Only

Aquifer: _____

Well #: C-291

Elevation: _____

County: TATE
Permit #: _____
Driller: BOB SMITH
Date completed: 10-26-08

This report be prepared by the pump installer in detail and filled with the Department within 30 days of completion of drilling of the well.

Well Owner Information	Well Location
Owner Name: <u>ROBERT FOSTER</u>	Latitude: _____ Longitude: _____
Mailing Address: <u>4314 KENBROOK DR.</u>	Method of Lat/Long (circle one): Conventional Survey
<u>HANDSOME, MS 38637</u>	USGS quad, Hand-held GPS, survey grade GPS
City State Zip Code	<u>1/4 1/4 Sec D-6 Twn T4S Rng R6W</u>
Telephone No. <u>(901) 949-7400</u>	Distance _____ Direction _____ Nearest Town _____
	<u>5 miles N of FORBUILE</u>

Pump Type	Power Type
Circle one	Circle one
Air lift Jet <u>Submersible</u>	Diesel Engine Gasoline Engine Natural Gas
Bucket Piston Turbine	<u>Electric Motor</u> Hand Tractor PTO
Centrifugal Rotary Flowing Well	Windmill Other(specify): _____
Other (specify): _____	Horse Power Rating of Motor: <u>1</u>
Date Pump Installed: <u>10-26-08</u>	Setting Depth: <u>100</u> feet
Rated Pump Capacity: <u>12</u> gallons per min	Number of Stages: <u>11</u>

Pump Test Data	Method of Measuring Water Level
Date Well Tested: <u>10-26-08</u>	circle one
Static Water Level(A): <u>60</u> feet below Land Surface	Air Line Electric Measuring Line Steel Tape
Rumping Water Level(B): _____ feet below Land Surface	Other(specify): <u>LINE & WEIGHT</u>
Drawdown[(B)-(A)]: _____ feet below Land Surface	For flowing well, measured shut in head: _____ feet
Test Pumping Rate: <u>14</u> gallons per Minute	Well yielded <u>14</u> GPM with a drawdown of _____ feet after _____ hours of pumping
Duration of Pump Test(minimum 4 hours): _____ hrs	

I HEREBY CERTIFY that the above statements are true to the best of my knowledge.

Bob Smith 0645 _____
Print Name of Pump Installer and License No. Signature of Pump Installer

RECEIVED
NOV 24 2008
BY: OLWR