	State W	ell Report		
County: Tote		Oriller's Log	For Office Use Only:	
Permit #:	Mississippi Department of Environmental Quality Office of Land and Water Resources		Aquifer:	
1111		Box 2309	Well#: <u>C 384</u>	
Driller: Jones as Maga		i, MS 39225	L. S. Elevation:	
Date drilling completed: 3-11-13		961- 5210 1- 5228 (fax)		
	, ,	, ,	E-log #:	
State Law requires that this report Department at the above address t				
Information on Well O			rehole Location	
(Landowner if borehole is not for	a water well)	34.43 ,18.0	4,	
Owner Name Joe Shorp		Latitude: 5 1 5 7 181	Longitude: <u>173 o 46 ,34.66</u> ne): Conventional Survey,	
Mailing Address: 3015 540		Method of Lat/Long (circle on	ne): Conventional Survey,	
			GPS Survey-grade GPS	
(oldwater Me	38618	NE 1/4 SE 1/4 Sec 24	1 1 1 1 1 1 1 1 1 1 1 1 1 1 1 1 1 1 1	
(oldwater Mg City State	Zip Code	Distance Direction	Nearest Town of New Gorden	
Telephone No. (662) 393-4559		vines	01 1000 000 qer	
	Well / Bore	hole Data		
Date drilling started: 3-11-13 Date drill	ling completed:3~U~ 13	Hole denth: 900	Hole diameter: 63/4	
Date drilling started: 3-11-13 Date drilling completed: 3-11-13 Hole depth: 900' Hole diameter: 63/4				
Location of the source of any surface water used for drilling:				
Logs run (circle all applicable) No log run Electric Gamma Ray Density Sonic Neutron Other: Name of organization running log(s):				
Purpose of borehole (check one): Water Well Geotechnical/Geological Investigation Ground Source Heat Pump				
Seismic Survey Other (describe)				
Purpose of Well (check one): Home / Inc				
If a flowing well, method of flow regulation: Valve μ Other (describe)				
Static Water Level: 80 feet above of below circle one) land surface Date measured: 3-11-13				
Method of Measurement (circle one) steel tape electric tape air line other: string weight				
Well depth: 300 Well grouted to a depth of 10 feet Type of grout (circle one): Neat Cement Bentonite Mix				
Casing length: 180 feet Casing	diameter: <u> </u>	_inches Type of casing:	DUC	
Screen length: <u>30</u> feet Screen				
Screen slot size: , O(O inches			-	
Type of completion (circle all applicable). Gravel packed, Underreamed Telescoped Open hole Natural Development				
Other (describe):				

Top of lap pipe or reduction in casing: feet. If telescoped or more than one screen, describe on next page

Form: OLWR-SWARE COOK ED

The sketch below only required for water well	The sketch	below	only	required	for	water	wells
---	------------	-------	------	----------	-----	-------	-------


If well te	elescopes,	show	denths	on	sketch.
27 11 000 00	TOUCO D'CO,	511011	wepino	UIL	Dittition.

If well telescopes,	show	depths	on	sketch.
Ground Level.		7		

Description of formations encountered must be provided for all wells and boreholes, unless specifically exempted by regulations

Description of Formations Encountered	From (depth)	10 (depth)
elan dirt	Ground Level	30
while soud	90	-7 ک
while clay	35	80
Blue clair	80	160
while soud	160	300

If more than one screen, show location of each on sketch

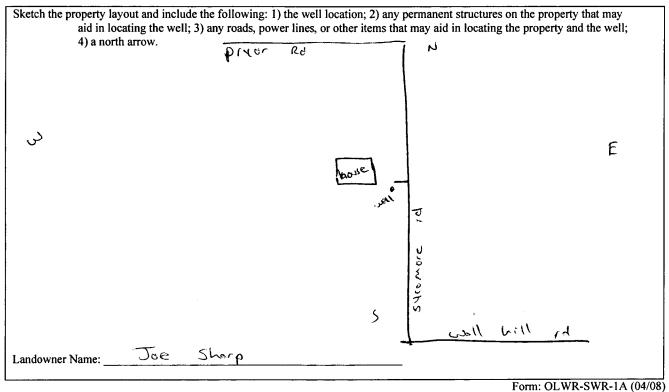

I certify that the well/borehole was drilled, constructed, and completed in accordance with all applicable requirements of the	
Mississippi Department of Environmental Quality and the Mississippi Department of Health regulations, if applicable and the	EL

bres W. Moson 0-620

APR 0 8 2013

STATE WELL REPORT Part 2

County: Tate

Date completed: 3 - 11 - 13

Copy information from block on Part 1

Pump Installer's Completion Report
Mississippi Department of Environmental Quality
Office of Land and Water Resources
P.O. Box 2309 Jackson, MS 39225 (601)961-5210 (601)961-5228 (fax)

For Office Use Only:	
Aquifer:	
Well #: <u>C384</u> Elevation:	-

This part of the report must be completed by a licensed water well contractor or a licensed pump installer. A copy of Part 1 of the report must be attached and both parts filed with the Department at the above address within 30 days of well completion.				
Well Owner Information	Well Location			
Owner Name: Joe Sharp	Latitude: 34.43.18.61 Longitude: 69.46. 34.66			
Mailing Address: 3015 Sycanore rd	Method of Lat/Long (check one): Conventional Survey,			
	USGS quad, Hand-held GPS, Survey-grade GPS			
City State Zip Code	NE 1/2 SE 1/2 Sec 24 T 45 R 6W			
	Distance Direction Nearest Town			
Telephone No. (662) 393-4559	112 Miles S of New Golden			
Pump Type Circle one	Power Type Circle one			

	Pump Type Circle one			Power Type Circle one	
Air Lift	Jet	Submersible	Diesel Engine	Gasoline Engine	Natural Gas
Bucket	Piston	Turbine	Electric Motor	Hand	Tractor PTO
Centrifugal	Rotary	Flowing Well	Windmill	Other (specify):	
Other (specify):			Horse Power Rating	of Motor: 3 /4	
Date Pump Installed: _	3-11-13		Setting Depth:	100	feet
Rated Pump Capacity:	10	Gallons Per Minute	Number of Stages: _	8	

Pump Test Data	Method of Measuring Water Level
Date Well Tested: 3 -11-13	Circle one
Static Water Level (A): Feet Below Land Surface	Air Line Electric Measuring Line Steel Tape
Pumping Water Level (B): Feet Below Land Surface	Other (specify): String weight
Drawdown [(B) – (A)]:Feet Below Land Surface	For flowing well, measured shut in head:feet
Test Pumping Rate: Gallons Per Minute	Well yieldedGPM with a drawdown of
Duration of Pump Test (minimum 4 hours):hours	feet after 24 hours of pumping

I HEREBY CERTIFY that the above statements are true to the best of	of my knowledge.	RECEIVEL
Janes W. Moson 0-620	ges w. M	APR 0 8 2013
Print Name of Pump Installer and License No. (if applicable)	Signature of Pump Installer	
	Form: OLV	VR-SWROLD (04/08)

BY. OLWH