

STATE WELL REPORT

Part 1

Driller's Log

Mississippi Department of Environmental Quality
Office of Land and Water Resources
P.O. Box 2309
Jackson, MS 39225-2309
(601)961-5210
(601)360-0535 (fax)

For Office Use Only:

Well #: 0386
Aquifer: _____
E-Log #: _____

County: Tate
Permit #: _____
Driller: Jones W. Masor
Date drilling completed: 10-14-13

State Law requires that this report be prepared by the license holder responsible for the work and filed with the Department at the above address within 30 days of completion of drilling of the well or borehole.

Well Owner Information (Landowner if borehole is not for a water well)	Well or Borehole Location
Owner Name: <u>Timmy Lentz</u>	Latitude: <u>34°45'48.60</u> Longitude: <u>89°48'14.93</u>
Mailing Address: <u>336 hope rd.</u>	Method of Lat/Long (check one): Conventional Survey _____, USGS quad _____, Hand-held GPS <input checked="" type="checkbox"/> , Survey-grade GPS _____
<u>Coldwater</u> City <u>ms</u> State <u>38618</u> Zip Code	<u>NE</u> 1/4 <u>SW</u> 1/4, Sec <u>2</u> T <u>45</u> R <u>6W</u>
Telephone No. <u>(901) 299-5355</u>	<u>1 1/2</u> Miles <u>nw</u> of <u>New Garden</u> (Distance) (Direction) (Nearest Town)

Well / Borehole Data	
Date drilling started: <u>10-14-13</u> Date drilling completed: <u>10-14-13</u> Hole depth: <u>185</u> Hole diameter: <u>6 3/4</u>	
Location of the source of any surface water used for drilling: <u>n/a</u>	
Method of dosing and volume of Chlorine used in drilling and development: <u>5 ppm and greater</u>	
Logs run (circle all applicable): <input checked="" type="checkbox"/> No log run <input type="checkbox"/> Electric <input type="checkbox"/> Gamma Ray <input type="checkbox"/> Density <input type="checkbox"/> Sonic <input type="checkbox"/> Neutron Other: _____	
Name of organization running log(s): <u>n/a</u>	
Purpose of borehole (circle one): <input checked="" type="checkbox"/> Water Well <input type="checkbox"/> Geotechnical/Geological Investigation <input type="checkbox"/> Ground Source Heat Pump <input type="checkbox"/> Seismic Survey Other (describe) _____	
<i>If drilling is not related to water well construction, skip the remainder of this block</i>	
Purpose of Well (circle all applicable): <input checked="" type="checkbox"/> Home <input type="checkbox"/> Industrial <input type="checkbox"/> Public Supply <input type="checkbox"/> Irrigation <input type="checkbox"/> Fish Culture	
Other (describe): <u>n/a</u>	
If a flowing well, method of flow regulation: Valve <u>n/a</u> Other (describe) _____	
Static Water Level: <u>60</u> feet [above or <input checked="" type="checkbox"/> below] land surface Date measured: <u>10-14-13</u> (circle one)	
Method of measurement (circle one): Steel tape Electric tape Air line Other (describe): <u>string weight</u>	
Well depth: <u>185</u> Well grouted to a depth of: <u>10</u> feet Type of grout (circle one): Neat Cement <input checked="" type="checkbox"/> Bentonite Mix	
Casing length: <u>175</u> feet Casing diameter: <u>4</u> inches Type of casing: <u>pvc</u>	
Screen length: <u>10</u> feet Screen diameter: <u>4</u> inches Type of screen: <u>pvc</u>	
Screen slot size: <u>.010</u> inches Setting depth: From <u>175</u> feet to <u>185</u> feet	
Type of completion (circle all applicable): <input checked="" type="checkbox"/> Gravel packed <input type="checkbox"/> Underreamed <input type="checkbox"/> Open hole <input type="checkbox"/> Natural Development	
Other (describe): <u>n/a</u>	
Top of lap pipe or reduction in casing: <u>n/a</u> feet	


If telescoped or more than one screen, describe on next page

County: Tate
 Permit #: _____

For Office Use Only:
 Well #: 0386

The sketch below only required for water wells

If well telescopes, show depths on sketch.

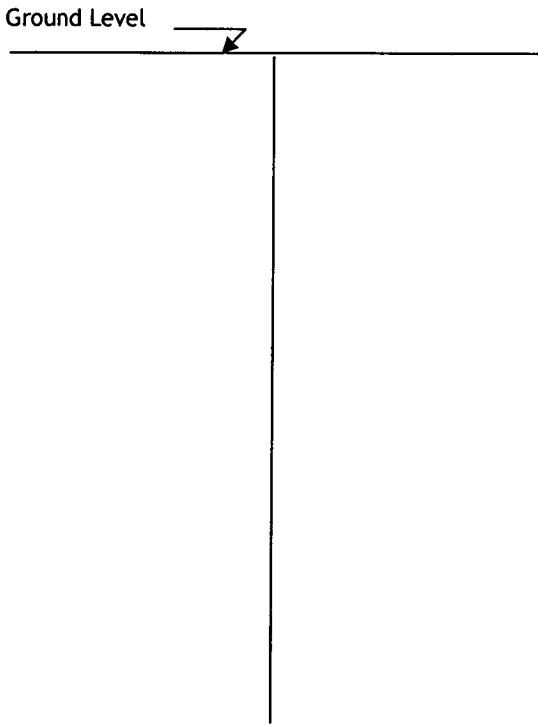


Description of formations encountered must be provided for all wells and boreholes, unless specifically exempted by regulations

Description of Formations Encountered	From (depth)	To (depth)
clay dirt.	Ground level	25
gravel	25	45
white clay	45	70
white sand	70	125
white clay	125	130
white sand	130	185

If more than one screen, show location of each on sketch

- Sketch the property layout and include the following:
- 1) the well location
 - 2) any permanent structures on the property that may aid in locating the well
 - 3) any roads, power lines, or other items that may aid in locating the property and the well
 - 4) north arrow

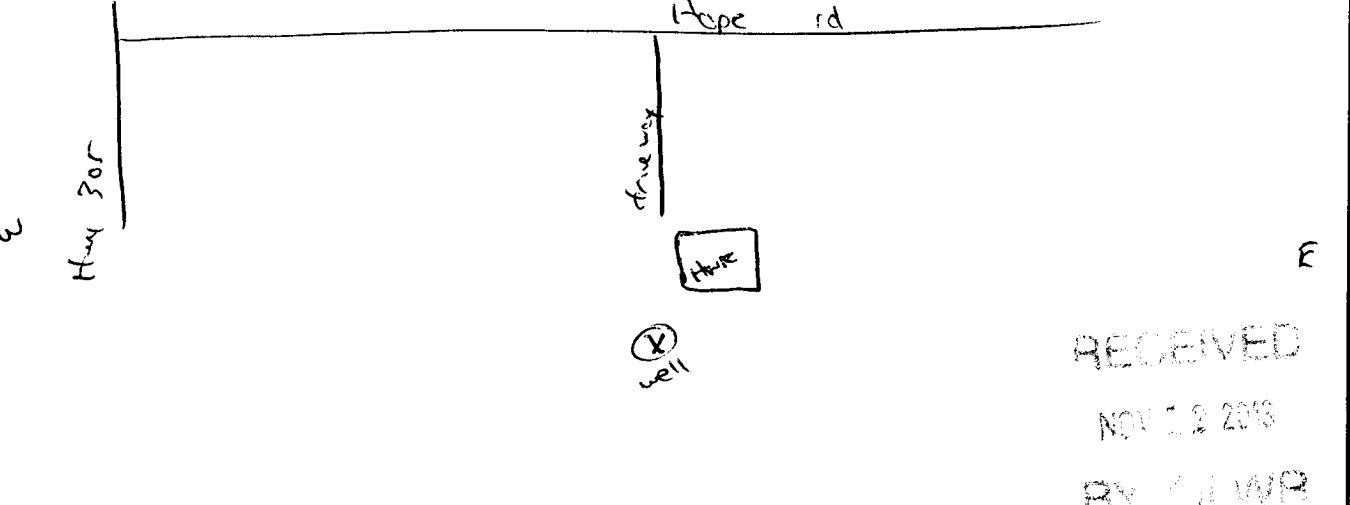

RECEIVED
 NOV 12 2013
 BY J. W. MASON

Landowner Name: Timmy Lentz

I HEREBY CERTIFY that the well/borehole was drilled, constructed, and completed in accordance with all applicable requirements of the Mississippi Department of Environmental Quality and the Mississippi Department of Health regulations, if applicable, and state laws.

Jones W. Mason 0-620 11-8-13 Jones W. Mason
 Print Name of Responsible Licensee and License No. Date Signature of Licensee

STATE WELL REPORT

Part 2

Pump Installer's Completion Report
 Mississippi Department of Environmental Quality
 Office of Land and Water Resources
 P.O. Box 2309
 Jackson, MS 39225-2309
 (601)961-5210
 (601) 360-0535 (fax)

For Office Use Only:

Well #: 0386
 Aquifer: _____

County: Tate
 Permit #: _____
 Driller: James W. Mason
 Date completed: 10-14-13
Copy information from block on Part 1

This part of the report must be completed by a licensed water well contractor or a licensed pump installer. A copy of Part 1 of the report must be attached and both parts filed with the Department at the above address within 30 days of well completion.

Well Owner Information	Well Location
Owner Name: <u>Timmy Lentz</u>	Latitude: <u>34°45'48.60</u> Longitude: <u>89°48'14.93</u>
Mailing Address: <u>336 hope rd</u>	Method of Lat/Long (check one): Conventional Survey _____, USGS quad _____, Hand-held GPS <input checked="" type="checkbox"/> , Survey-grade GPS _____
<u>Caldwater</u> MS 38618 City State Zip Code	<u>NE 1/4 SW 1/4, Sec 2 T 45 R 6W</u> <u>1 1/2</u> Miles <u>NW</u> of <u>New Garden</u> (Distance) (Direction) (Nearest Town)
Telephone No. (901) <u>299-5355</u>	

Pump Type (circle one)

Submersible Turbine Air Lift Centrifugal Flowing Well Jet Piston Rotary Other (describe): _____

Date Pump Installed: 10-14-13 Rated Pump Capacity: 10 Gallons Per Minute

Is This Pump (circle one): New Repaired Replacement

Power Type (circle one)

Electric Diesel Gasoline Natural Gas Tractor PTO Windmill Other (describe): _____

Horse Power Rating of Motor: 3/4 Setting Depth: 100 feet Number of Stages: 8

Pump Test Data for Non Flowing Well

Date Well Tested: 10-14-13 Duration of Pump Test (minimum 4 hours): 24 hours

Static Water Level (A): 60 Feet Below Land Surface Pumping Water Level (B): N/A Feet Below Land Surface

Drawdown [(B) - (A)]: N/A Feet Below Land Surface Test Pumping Rate: 10 Gallons Per Minute

Method of measurement (circle one): Steel tape Electric tape Air line Other (describe): String Weight

Pump Test Data for Flowing Well

Measured shut in head: N/A feet.

Well yielded 10 GPM with a drawdown of N/A feet after 24 hours of pumping

Meter Installation

Meter Manufacturer: N/A Meter Serial Number: N/A

Meter Model Number/Name: N/A Type of Meter: N/A **RECORDED**

Totalizer Register Unit and Multiplier Factor (AF x .001, gal x 1000, etc): N/A **RECORDED**

Installation Date: N/A Meter installed by: N/A **BY SIGNATURE**

Is This Meter (circle one): New Repaired Replacement

Important: By submitting the above information you are certifying that this meter was installed to manufacturer standards. For agricultural wells, a list of approved meters is on the MDEQ website.

I HEREBY CERTIFY that the above statements are true to the best of my knowledge.

James W. Mason 0-620 11-8-13 James W. Mason
 Print Name of Pump Installer and License No. (if applicable) Date Signature of Pump Installer