

360

STATE WELL REPORT

Part 1

Driller's Log

Mississippi Department of Environmental Quality
Office of Land and Water Resources
P.O. Box 2309
Jackson, MS 39225-2309
(601)961-5210
(601)360-0535 (fax)

For Office Use Only:

Well #: C414
Aquifer: _____
E-Log #: _____

County: Tate
Permit #: _____
Driller: Jones W. Mason
Date drilling completed: 10-2-18

State Law requires that this report be prepared by the license holder responsible for the work and filed with the Department at the above address within 30 days of completion of drilling of the well or borehole.

Well Owner Information <i>(Landowner if borehole is not for a water well)</i>	Well or Borehole Location
Owner Name: <u>Toby Boson</u>	Latitude: <u>34°46'10.00"N</u> Longitude: <u>89°50'03.14"W</u>
Mailing Address: <u>3725 county line rd.</u>	Method of Lat/Long (check one): Conventional Survey _____
<u>Coldwater</u> MS <u>38618</u>	USGS quad _____, Hand-held GPS <input checked="" type="checkbox"/> , Survey-grade GPS _____
City State Zip Code	<u>NE</u> ^{NE} <u>1/4</u> <u>NE</u> <u>1/4</u> , Sec <u>4</u> <input checked="" type="checkbox"/> T <u>4s</u> <input checked="" type="checkbox"/> R <u>6w</u> <input checked="" type="checkbox"/>
Telephone No. <u>(901) 326-8710</u>	<u>1 3/4</u> Miles <u>NE</u> of <u>gingerhill</u> (Distance) (Direction) (Nearest Town)

Well / Borehole Data

Date drilling started: 10-2-18 Date drilling completed: 10-2-18 Hole depth: 145 Hole diameter: 2"

Location of the source of any surface water used for drilling: NIA

Method of dosing and volume of Chlorine used in drilling and development: 50 ppm and greater

Logs run (circle all applicable): No log run Electric Gamma Ray Density Sonic Neutron Other: _____

Name of organization running log(s): NIA

Purpose of borehole (circle one): Water Well Geotechnical/Geological Investigation Ground Source Heat Pump
 Seismic Survey Other (describe) NIA

If drilling is not related to water well construction, skip the remainder of this block

Purpose of Well (circle all applicable): Home Industrial Public Supply Irrigation Fish Culture

Other (describe): _____

If a flowing well, method of flow regulation: Valve NIA Other (describe) _____

Static Water Level: 80 feet [above or below] land surface Date measured: 10-2-18
(circle one)

Method of measurement (circle one): Steel tape Electric tape Air line Other (describe): string/weight

Well depth: 145 Well grouted to a depth of: 50 feet Type of grout (circle one): Neat Cement Bentonite Mix

Casing length: 125 feet Casing diameter: 4 inches Type of casing: pvc

Screen length: 20 feet Screen diameter: 4 inches Type of screen: pvc

Screen slot size: .010 inches Setting depth: From 125 feet to 145 feet

Type of completion (circle all applicable): Gravel packed Underreamed Open hole Natural Development

Other (describe): NIA

Top of lap pipe or reduction in casing: NIA feet

If telescoped or more than one screen, describe on next page


RECEIVED
OCT 31 2018
BY OLWR

County: _____
Permit #: _____

For Office Use Only:
Well #: C414

The sketch below only required for water wells


If well telescopes, show depths on sketch.

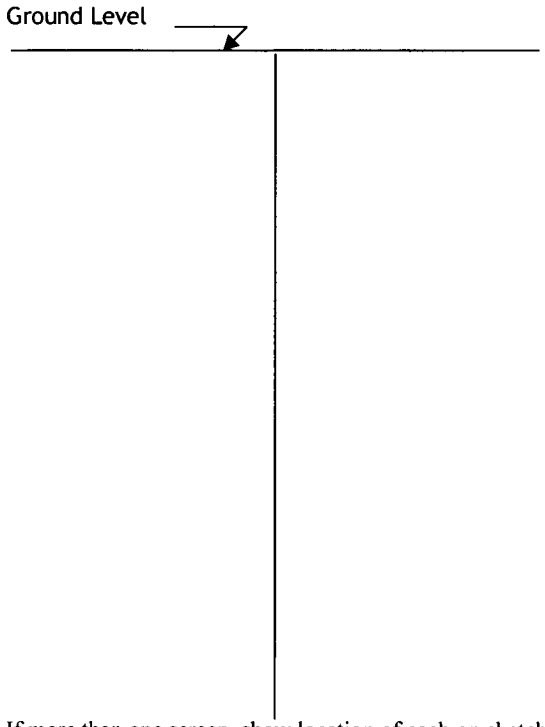

Description of formations encountered must be provided for all wells and boreholes, unless specifically exempted by regulations

Description of Formations Encountered	From (depth)	To (depth)
clay dirt	Ground level	15
gravel	15	25
white clay	25	40
white sand	40	80
white clay	80	90
white sand	90	145

If more than one screen, show location of each on sketch

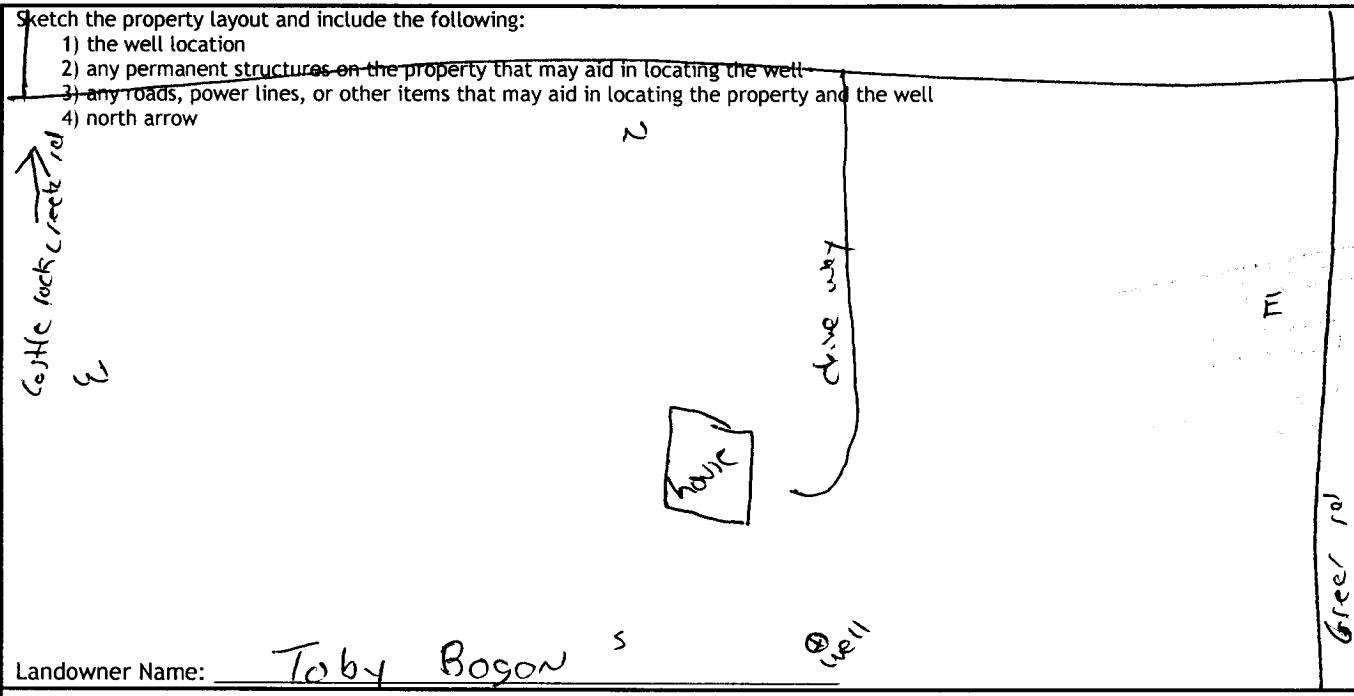

Landowner Name: Toby Bogon

I HEREBY CERTIFY that the well/borehole was drilled, constructed, and completed in accordance with all applicable requirements of the Mississippi Department of Environmental Quality and the Mississippi Department of Health regulations, if applicable, and state laws.

Jones W. Masen 0-670 10-28-10 Jones W. Masen
Print Name of Responsible Licensee and License No. Date Signature of Licensee

STATE WELL REPORT

Part 2

Pump Installer's Completion Report

Mississippi Department of Environmental Quality
Office of Land and Water Resources
P.O. Box 2309
Jackson, MS 39225-2309
(601)961-5210
(601) 360-0535 (fax)

For Office Use Only:

Well #: CA1A

Aquifer: _____

County: Tate
Permit #: _____
Driller: Jones W. Mason
Date completed: 10-2-18
Copy information from block on Part 1

This part of the report must be completed by a licensed water well contractor or a licensed pump installer. A copy of Part 1 of the report must be attached and both parts filed with the Department at the above address within 30 days of well completion.

Well Owner Information	Well Location
Owner Name: <u>Toby Bogow</u>	Latitude: <u>34°46'10.00"N</u> Longitude: <u>89°50'03.14"W</u>
Mailing Address: <u>3725 countyline rd.</u>	Method of Lat/Long (check one): Conventional Survey _____, USGS quad _____, Hand-held GPS <input checked="" type="checkbox"/> , Survey-grade GPS _____
City: <u>Coldwater</u> State: <u>MS</u> Zip Code: <u>38618</u>	<u>NE NW</u> 1/4 <u>NE</u> 1/4, Sec <u>4</u> T <u>4s</u> R <u>6w</u>
Telephone No. (901) <u>326-8710</u>	<u>13/4</u> Miles <u>NE</u> of <u>gingerhill</u> (Distance) (Direction) (Nearest Town)

Pump Type (circle one)
 Submersible Turbine Air Lift Centrifugal Flowing Well Jet Piston Rotary Other (describe): _____
Date Pump Installed: 10-2-18 Rated Pump Capacity: 10 Gallons Per Minute
Is This Pump (circle one): New Repaired Replacement

Power Type (circle one)
 Electric Diesel Gasoline Natural Gas Tractor PTO Windmill Other (describe): _____
Horse Power Rating of Motor: 1 hp Setting Depth: 120 feet Number of Stages: 11

Pump Test Data for Non Flowing Well
Date Well Tested: 10-2-18 Duration of Pump Test (minimum 4 hours): 24 hours
Static Water Level (A): 80 Feet Below Land Surface Pumping Water Level (B): N/A Feet Below Land Surface
Drawdown [(B) - (A)]: N/A Feet Below Land Surface Test Pumping Rate: 10 Gallons Per Minute
Method of measurement (circle one): Steel tape Electric tape Air line Other (describe): string/weight

Pump Test Data for Flowing Well
Measured shut in head: N/A feet.
Well yielded 10 GPM with a drawdown of N/A feet after 24 hours of pumping

Meter Installation
Meter Manufacturer: N/A Meter Serial Number: N/A
Meter Model Number/Name: N/A Type of Meter: N/A
Totalizer Register Unit and Multiplier Factor (AF x .001, gal x 1000, etc): N/A
Installation Date: N/A Meter installed by: N/A
Is This Meter (circle one): New Repaired Replacement

Important: By submitting the above information you are certifying that this meter was installed to manufacturer standards. For agricultural wells, a list of approved meters is on the MDEQ website.

I HEREBY CERTIFY that the above statements are true to the best of my knowledge.
Jones W. Mason 0-670 10-28-18 Jones W. Mason
Print Name of Pump Installer and License No. (if applicable) Date Signature of Pump Installer